


15-065-00716-00-01

WELL PLUGGING RECORD

Give All Information Completely
Make Required Affidavit
Mail or Deliver Report to:
Conservation Division
State Corporation Commission
212 North Market, Insurance Bldg.
Wichita, Kansas

Graham County. Sec. 24 Twp. 8S Rge. 24 (X) (W)
Location as "NE/CNW/SW" or footage from lines SE SE NW
Lease Owner D. R. Lauck Oil Co., Inc.
Lease Name Kobler Well No. 1
Office Address 301 South Broadway, Wichita, Kansas 67202
Character of Well (completed as Oil, Gas or Dry Hole) Dry Hole
Date well completed June 4 19 64
Application for plugging filed May 27 19 64
Application for plugging approved May 29 19 64
Plugging commenced June 5 19 64
Plugging completed June 10 19 64
Reason for abandonment of well or producing formation Non Productive

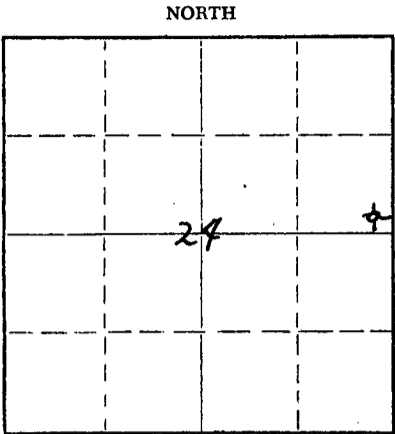

Locate well correctly on above Section Plat

If a producing well is abandoned, date of last production _____ 19____
Was permission obtained from the Conservation Division or its agents before plugging was commenced? Yes

Name of Conservation Agent who supervised plugging of this well Mr. W. L. Nichols
Producing formation Lansing Depth to top 3567 Bottom 3800 Total Depth of Well 3800 Feet
Show depth and thickness of all water, oil and gas formations. P.B. 3778

OIL, GAS OR WATER RECORDS

CASING RECORD

FORMATION	CONTENT	FROM	TO	SIZE	PUT IN	PULLED OUT
<u>Lansing</u>	<u>Dry</u>	<u>3567</u>	<u>3800</u>	<u>8 5/8</u>	<u>208</u>	<u>None</u>
				<u>5 1/2</u>	<u>3800</u>	<u>1104</u>

Describe in detail the manner in which the well was plugged, indicating where the mud fluid was placed and the method or methods used in introducing it into the hole. If cement or other plugs were used, state the character of same and depth placed, from _____ feet to _____ feet for each plug set.

Set Plug @ 3700'
4 Sx. Cement
Pulled Pipe to 600' pumped 21 sx. mud
Pulled pipe to 540' pumped 20 sx. cement
Pulled pipe to 200' pumped 20 sx. cement
Pulled pipe to 35' pumped 10 sx. cement to base of cellar


(If additional description is necessary, use BACK of this sheet)

Name of Plugging Contractor Glenn & Smith Pipe Pulling Co.
Address P. O. Box 156, Ellinwood, Kansas 67526

STATE OF Kansas, COUNTY OF Barton, ss.
H. E. Wolfe (employee of owner) or (~~owner or operator~~) of the above-described well, being first duly sworn on oath, says: That I have knowledge of the facts, statements, and matters herein contained and the log of the above-described well as filed and that the same are true and correct. So help me God.

(Signature) [Signature]
Box 488, Ellinwood, Kansas 67526
(Address)

SUBSCRIBED AND SWORN TO before me this 16th day of June, 19 64

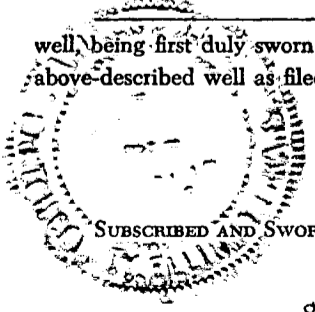

My commission expires 8/21/65
Arleen Doll Notary Public.

6-17-64