


15-065-00967-00-00

STATE OF KANSAS  
STATE CORPORATION COMMISSION  
Give All Information Completely  
Make Required Affidavit  
Mail or Deliver Report to:  
Conservation Division  
State Corporation Commission  
211 No. Broadway  
Wichita, Kansas

WELL PLUGGING RECORD

Graham County, Sec. 25 Twp. 8S Rge. 24W (E) (W)  
Location as "NE/CNW%SW%" or footage from lines NW NW SE  
Lease Owner Burch Drilling Co., Inc.  
Lease Name Kobler Well No. 1  
Office Address 1011 Union Center - Wichita, Kansas  
Character of Well (completed as Oil, Gas or Dry Hole) dry  
Date well completed 12-11 19 57  
Application for plugging filed 12-11 19 57  
Application for plugging approved 12-11 19 57  
Plugging commenced 12-11 19 57  
Plugging completed 12-11 19 57  
Reason for abandonment of well or producing formation dry

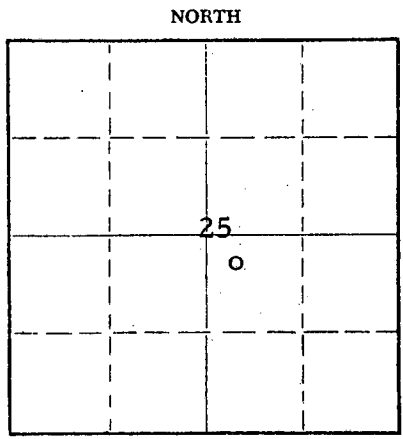

Locate well correctly on above Section Plat

If a producing well is abandoned, date of last production 19  
Was permission obtained from the Conservation Division or its agents before plugging was commenced? yes

Name of Conservation Agent who supervised plugging of this well Eldon Petty  
Producing formation \_\_\_\_\_ Depth to top \_\_\_\_\_ Bottom \_\_\_\_\_ Total Depth of Well 3905 Feet  
Show depth and thickness of all water, oil and gas formations.

OIL, GAS OR WATER RECORDS

CASING RECORD

FORMATION	CONTENT	FROM	TO	SIZE	PUT IN	PULLED OUT
				8 5/8	226	none

Describe in detail the manner in which the well was plugged, indicating where the mud fluid was placed and the method or methods used in introducing it into the hole. If cement or other plugs were used, state the character of same and depth placed, from \_\_\_\_\_ feet to \_\_\_\_\_ feet for each plug set.

Set 1st plug @ 650' w/20 sx. cement.  
Set 2nd plug @ 210' w/15 sx. cement.  
Set 3rd plug @ 40' w/10 sx. cement.

RECEIVED  
STATE CORPORATION COMMISSION

DEC 18 1957

CONSERVATION DIVISION  
Wichita, Kansas

12-18-57

(If additional description is necessary, use BACK of this sheet)

Name of Plugging Contractor Burch Drilling Co., Inc.  
Address 1011 Union Center - Wichita, Kansas

STATE OF Kansas, COUNTY OF Sedgwick, ss.  
Earl M. Burch (employee of owner) or (owner or operator) of the above-described well, being first duly sworn on oath, says: That I have knowledge of the facts, statements, and matters herein contained and the log of the above-described well as filed and that the same are true and correct. So help me God.

(Signature) Earl M. Burch

(Address) \_\_\_\_\_  
Dec. 16, 19 57.

Betty Spriggs  
Notary Public.



PLUGGING  
FILE SEC 25 T 8 R 24W  
BOOK PAGE 69 LINE 22

15-065-00967-00-00

WELL LOG

Burch Drilling Co., Inc.  
#1 Kobler  
NW NW SE 25-8S-24W  
Graham County, Kansas

8 5/8" @ 226' w/150 sz.  
Elevation: 2325' KB  
Comm: 11-30-57  
Comp: 12-11-57  
D & A

Tops:

1240 Shale & Shells  
1406 Shale, Lime Streaks  
1450 Red Bed & Lime streaks  
2000 Shale & Lime  
2030 Shale & Shells  
2070 Anhydrite  
2315 Shale  
3704 Shale & Lime  
3757 Cherty Lime  
3905 Lime  
  
3905 RTD

Heebner 3645  
Toronto 3669  
Lansing 3682

DST #1 3760-3787 1 hr.  
Rec. 80' muddy salt wtr.  
BHP 780#.

State of Kansas, County of Sedgwick:

Earl M. Burch, president of Burch Drilling Co., Inc. being first duly sworn on oath, says: That I have knowledge of the facts, statements, and matters herein contained and the log of the above-described well as filed and that the same are true and correct.

*Earl M. Burch*

Subscribed and sworn to before this 16th day of Dec. 1957.



My commission expires: June 15, 1958

RECEIVED  
STATE CORPORATION COMMISSION  
12-18-57  
DEC 18 1957

*Betty Spraggal*  
Notary Public

CONSERVATION DIVISION  
Wichita, Kansas

PLUGGING  
FILE SEC 25 T 8 R 24a  
BOOK PAGE 69 LINE 22