

STATE OF KANSAS
STATE CORPORATION COMMISSION

WELL PLUGGING RECORD

Give All Information Completely
Make Required Affidavit
Mail or Deliver Report to:
Conservation Division
State Corporation Commission
800 Bitting Building
Wichita, Kansas

Graham County, Sec. 26 Twp. 8S Rge. 24 (EXX) (W)

Location as "NE/CNW $\frac{1}{4}$ /SW $\frac{1}{4}$ " or footage from lines NW NW NW

Lease Owner Peel-Hardman

Lease Name Kobler Well No. 1

Office Address _____

Character of Well (completed as Oil, Gas or Dry Hole) Dry Hole

Date well completed March 25 19 51

Application for plugging filed March 25 19 51

Application for plugging approved March 25 19 51


Plugging commenced March 25 19 51

Plugging completed March 25 19 51

Reason for abandonment of well or producing formation _____

If a producing well is abandoned, date of last production _____ 19 _____

Was permission obtained from the Conservation Division or its agents before plugging was commenced? _____

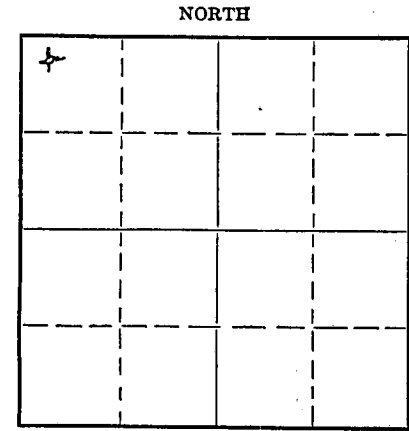

Locate well correctly on above
Section Plat

Name of Conservation Agent who supervised plugging of this well E. R. Petty, Hays, Kansas

Producing formation _____ Depth to top _____ Bottom _____ Total Depth of Well 4256 Feet

Show depth and thickness of all water, oil and gas formations.


OIL, GAS OR WATER RECORDS

CASING RECORD

Formation	Content	From	To	Size	Put In	Pulled Out
		0	16 $\frac{1}{2}$ '	8 5/8"	16 $\frac{1}{2}$ '	None

Describe in detail the manner in which the well was plugged, indicating where the mud fluid was placed and the method or methods used in introducing it into the hole. If cement or other plugs were used, state the character of same and depth placed, from _____ feet to _____ feet for each plug set.

- 4256' - 161 $\frac{1}{2}$ ' - Heavy Rotary Mud
- 161 $\frac{1}{2}$ ' - 160' - Wooden Plug
- 160' - 114' - 15 Sacks Cement
- 114' - 41 $\frac{1}{2}$ ' - Heavy Rotary Mud
- 41 $\frac{1}{2}$ ' - 40' - Wooden Plug
- 40' - 6' - 10 Sacks Cement
- 6' - Surface - Cellar

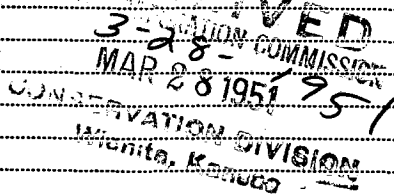

(If additional description is necessary, use BACK of this sheet)

Correspondence regarding this well should be addressed to Peel-Hardman, P. O. Box 359
Address Hoisington, Kansas

STATE OF KANSAS, COUNTY OF BARTON, ss.

Peel-Hardman (employee or owner) or (owner or operator) of the above-described well, being first duly sworn on oath, says: That I have knowledge of the facts, statements, and matters herein contained and the log of the above-described well as filed, and that the same are true and correct. So help me God. PEEL-HARDMAN

(Signature) Wm Herbert BY: _____

P. O. Box 359, Hoisington, Kansas
(Address)

SUBSCRIBED AND SWORN to before me this 27th day of March, 19 51

Marion M. Herbert
Notary Public.

My commission expires June 4, 1951

28-5091-s 8-50-10M

PLUGGING

FILE SEC 26 T 8 R 4 W

BOOK PAGE 69 LINE 27

DRILLER'S LOG

Company: Peel-Hardman
Farm: Kobler Well No. 1

NW NW NW
Sec. 26 Twp. 8S Rge. 24W

Total Depth: 4256'

County: Graham,
Kansas

Comm: 3-13-51 Comp: 3-25-51

Contractor: Peel-Hardman

Elevation:

Casing:

Production: Dry

8 5/8" 164' cem.

Figures below indicate bottom of formations

Soil & Sand	0 -	85
Shale		164
Shells		350
Shale		1050
Sand		1190
Shale		1230
Shale & Sand		1750
Shale		2065
Ahhydrite		2105
Shale & Shells		2350
Shale & Lime		2540
Shale & Shells		3065
Shale & Lime		3490
Lime		4040
Lime & Shale		4070
Lime		4110
Lime & Shale		4150
Conglomerate		4165
Lime		4195
Lime & Chert		4256
Total Depth		4256

This is to certify that the above information is, to the best of our knowledge true and correct.

PEEL-HARDMAN

BY: *Way Herbst*

SUBSCRIBED AND SWORN to before me this 27th day of March, 1951.

My commission expires June 4, 1951 *Marion M. Herbst*
Notary Public



PLUGGING
FILE SEC 24 T 8 R NW
BOOK PAGE 69 LINE 37

RECEIVED
COMMISSION
MAR 28 1951
3-28-1951
DIVISION
Kansas