

STATE OF KANSAS  
STATE CORPORATION COMMISSION

Give All Information Completely  
Make Required Affidavit  
Mail or Deliver Report to:  
Conservation Division  
State Corporation Commission  
211 No. Broadway  
Wichita, Kansas

WELL PLUGGING RECORD

Graham County. Sec. 36 Twp. 8S Rge. (E)24 (W)

Location as "NE/CNW%SW%" or footage from lines NW NW SE

Lease Owner John O. Farmer, Inc.

Lease Name Kobler 'C' Well No. 3

Office Address 370 W. Wichita, Russell, Kansas

Character of Well (completed as Oil, Gas or Dry Hole) Dry

Date well completed 10/20/ 19 60

Application for plugging filed 10/20 19 60

Application for plugging approved 10/20 19 60


Plugging commenced 10/20 19 60

Plugging completed 10/20 19 60

Reason for abandonment of well or producing formation Dry

If a producing well is abandoned, date of last production \_\_\_\_\_ 19 \_\_\_\_\_

Was permission obtained from the Conservation Division or its agents before plugging was commenced? Yes

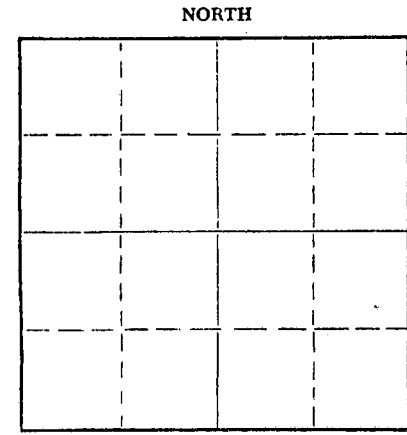

Locate well correctly on above Section Plat

Name of Conservation Agent who supervised plugging of this well Al Fabricius, Hill City, Kansas

Producing formation \_\_\_\_\_ Depth to top \_\_\_\_\_ Bottom \_\_\_\_\_ Total Depth of Well 3890 Feet

Show depth and thickness of all water, oil and gas formations.

OIL, GAS OR WATER RECORDS

CASING RECORD

FORMATION	CONTENT	FROM	TO	SIZE	PUT IN	PULLED OUT

Describe in detail the manner in which the well was plugged, indicating where the mud fluid was placed and the method or methods used in introducing it into the hole. If cement or other plugs were used, state the character of same and depth placed, from \_\_\_\_\_ feet to \_\_\_\_\_ feet for each plug set.

First Plug 400' with 20 sacks.  
Second Plug 160' with 20 sacks cement  
Third Plug 40' with 10 sacks cement

RECEIVED  
STATE CORPORATION COMMISSION  
OCT 1 1962  
10-1  
CONSERVATION DIVISION  
Wichita, Kansas

(If additional description is necessary, use BACK of this sheet)

Name of Plugging Contractor John O. Farmer, Inc.  
Address Russell, Kansas


STATE OF Kansas, COUNTY OF Russell, ss.  
John O. Farmer (employee of owner) or (owner or operator) of the above-described

well, being first duly sworn on oath, says: That I have knowledge of the facts, statements, and matters herein contained and the log of the above-described well as filed and that the same are true and correct. So help me God.

(Signature) John O. Farmer President  
Russell, Kansas (Address)

SUBSCRIBED AND SWORN TO before me this 29<sup>th</sup> day of September, 19 62

My commission expires 5/18/64

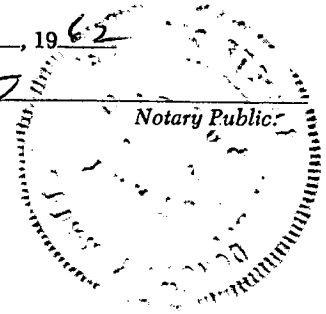


OPERATOR John O. Farmer, Inc.

ADDRESS Russell, Kansas

Give detailed description and thickness of all formation drilled through, contents of sand, whether dry, water, oil or gas.

640 Acres  
N

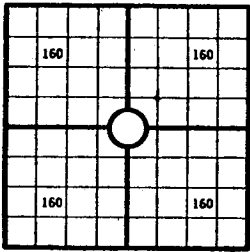

Locate well correctly

COUNTY Graham, SEC. 26, TWP. 8S, RGE. 24W

COMPANY OPERATING John O. Farmer, Inc.

OFFICE ADDRESS Russell, Kansas

DRILLING STARTED 10/12 60 DRILLING FINISHED 10/20 60

DATE OF FIRST PRODUCTION \_\_\_\_\_ COMPLETED \_\_\_\_\_

WELL LOCATED 1/4 1/4 1/4 North of South

Line and 1/4 1/4 1/4 ft. East of West Line of Quarter Section

Elevation (Relative to sea level) DERRICK FLOOR \_\_\_\_\_ GROUND, \_\_\_\_\_

CHARACTER OF WELL (Oil, gas or dryhole) 2357 2355

Dry

OIL OR GAS SANDS OR ZONES

Name	From	To	Name	From	To
1			4		
2			5		
3			6		

Perforating Record If Any

Shot Record

Formation	From	To	No. of Shots	Formation	From	To	Size of Shot

CASING RECORD

Amount Set							Amount Pulled		Packer Record		
Size	Wt.	Thds.	Make	Ft.	In.	Ft.	In.	Size	Length	Depth Set	Make

Liner Record: Amount \_\_\_\_\_ Kind \_\_\_\_\_ Top \_\_\_\_\_ Bottom \_\_\_\_\_

CEMENTING AND MUDDING

Size	Amount Set		Sacks Cement	Chemical		Method of Cementing	Amount	Mudding Method	Results (See Note)
	Ft.	In.		Gal.	Make				
8 5/8	167	120							

Note: What method was used to protect sands if outer strings were pulled?

NOTE: Were bottom hole plugs used? If so, state kind, depth set and results obtained

TOOLS USED

Rotary Tools were used from \_\_\_\_\_ feet to \_\_\_\_\_ feet to \_\_\_\_\_ feet, and from 0 feet to 3890 feet, and from \_\_\_\_\_ feet to \_\_\_\_\_ feet.

Type Rig \_\_\_\_\_

INITIAL PRODUCTION TEST

Describe initial test: whether by flow through tubing or casing or by pumping \_\_\_\_\_

Amount of Oil Production \_\_\_\_\_ bbls. Size of choke, if any \_\_\_\_\_ Length of test \_\_\_\_\_ Water

Production \_\_\_\_\_ bbls. Gravity of oil \_\_\_\_\_ Type of Pump if pump is used, describe \_\_\_\_\_

Formation	Top	Bottom	Formation	Top	Bottom
Surface	0	165			
Shale	160	300			
Shale & Sand	300	1500			
Sand & Shale	1500	1860			
Red Bed	1860	1980			
Shale & Shells	1980	2060			
Anhydrite	2060	2095			
Shale & Shells	2095	2700	<u>TOPS</u>		
Shale & Lime	2700	3070	Huebner Shale	3642	(-1283)
Lime & Shale	3070	3145	Toronto Limest	3665	(-1306)
Shale & Lime	3145	3345	Lansing/K. C.	3683	(-1324)
Lime & Shale	3345	3445	T. D.	3890	(-1531)
Shale & Lime	3445	3535			
Lime & Shale	3535	3720			
Lime	3720	3777			
Lime & Chert	3777	3890			
T. D.	<del>3890</del>	3890			

RECEIVED  
STATE CORPORATION COMMISSION

SEP 25 1967  
9-26-67  
CONSERVATION DIVISION  
STATE OF KANSAS

I, the undersigned, being first duly sworn upon oath, state that this well record is true, correct and complete according to the records of this office and to the best of my knowledge and belief.

John O. Farmer  
Name and title of representative of company  
President

Subscribed and sworn to before me this \_\_\_\_\_ day of \_\_\_\_\_ 1960

My Commission expires \_\_\_\_\_ 26th October \_\_\_\_\_ 60  
Notary Public Dorothy Kates

5/18/64

15-065-02022-00  
WELL NO. 3 COUNTY Graham County, Kansas  
FARM NAME KOHLER "C"