


STATE OF KANSAS
STATE CORPORATION COMMISSION

WELL PLUGGING RECORD

Give All Information Completely
Make Required Affidavit
Mail or Deliver Report to:
Conservation Division
State Corporation Commission
211 No. Broadway
Wichita, Kansas

NORTH

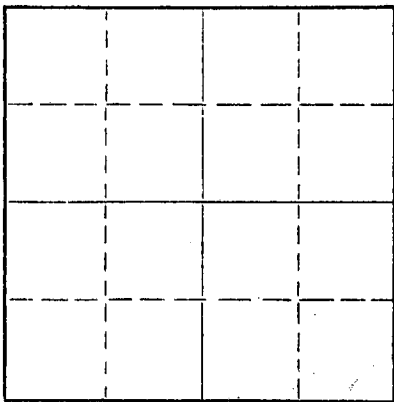

Locate well correctly on above
Section Plat

Graham County. Sec. 27 Twp. 8 Rge. 24W (E) (W)
Location as "NE/CNW/SW" or footage from lines NW NW SW
Lease Owner El Dorado Refining Company
Lease Name Higer Well No. 1
Office Address 306 Koch Building, Wichita, Kansas
Character of Well (completed as Oil, Gas or Dry Hole) Dry Hole
Date well completed January 21 1956
Application for plugging filed January 21 1956
Application for plugging approved January 21 1956
Plugging commenced January 21 1956
Plugging completed January 21 1956
Reason for abandonment of well or producing formation oil in commercial quantities not found
If a producing well is abandoned, date of last production 19
Was permission obtained from the Conservation Division or its agents before plugging was commenced? yes

Name of Conservation Agent who supervised plugging of this well Eldon Petty
Producing formation _____ Depth to top _____ Bottom _____ Total Depth of Well 3960 Feet
Show depth and thickness of all water, oil and gas formations.

OIL, GAS OR WATER RECORDS

CASING RECORD

FORMATION	CONTENT	FROM	TO	SIZE	PUT IN	PULLED OUT
				8-5/8"	321'	none

Describe in detail the manner in which the well was plugged, indicating where the mud fluid was placed and the method or methods used in introducing it into the hole. If cement or other plugs were used, state the character of same and depth placed, from _____ feet to _____ feet for each plug set.

Filled hole with extra heavy rotary mud from total depth to 300'. Set #1 plug with 15 sacks cement. Filled hole with extra heavy rotary mud to 24'. Set #2 plug with 10 sacks cement.

RECEIVED
STATE CORPORATION COMMISSION
FEB 1 1956
2-4-1956
CONSERVATION DIVISION
Wichita, Kansas

(If additional description is necessary, use BACK of this sheet)
Name of Plugging Contractor Prime Drilling Company
Address 1005 Central Building, Wichita, Kansas

STATE OF KANSAS, COUNTY OF SEDGWICK, ss.
L. J. Clampitt (employee of owner) or (owner or operator) of the above-described well, being first duly sworn on oath, says: That I have knowledge of the facts, statements, and matters herein contained and the log of the above-described well as filed and that the same are true and correct. So help me God.

(Signature) [Signature]
L. J. Clampitt
1005 Central Building, Wichita, Kansas
(Address)

SUBSCRIBED AND SWORN TO before me this 1st day of February, 1956

My commission expires September 30, 1959

[Signature] Notary Public.



PLUGGING
FILE SEC 27 T 8 R 24W
BOOK PAGE 33 LINE 7

ROTARY DRILLING LOG

OPERATOR: El Dorado Refining Company
Higer #1
NWNW SW Sec. 27-8-24W,
Graham County, Kansas

CONTRACTOR: Prime Drilling Company
COMM: 1/11/56
COMP: 1/21/56

Formations:

Surface Clay	20'
Sand	60'
Gray Shale	321'
Shale	760'
Shale & Shell	1143'
Shale & Sand	1370'
Shale, Shells & Red Bed	1610'
Shale & Shells	2050'
Shale, Red Bed & Shale	2087'
Anhydrite	2125'
Shale & Shell	2360'
Lime & Shale	3585'
Lime	3960'
Rotary Total Depth (D&A)	3960'

Remarks: Set 8-5/8" surface casing
at 321' cemented with 250 sacks, 2%
C. C.

We certify the above log is true
and correct to the best of our
knowledge and belief.

PRIME DRILLING COMPANY

R. R. McNicol

R. R. McNicol

FEB 4 1956
2-4-1956
MINERAL DIVISION
LAW OFFICE

PLUGGING

FILE SEC 27-8-24W

BOOK PAGE 33 LINE 7