


STATE OF KANSAS
STATE CORPORATION COMMISSION

WELL PLUGGING RECORD

Give All Information Completely
Make Required Affidavit
Mail or Deliver Report to:
Conservation Division
State Corporation Commission
212 No. Market
Wichita, Kansas

NORTH

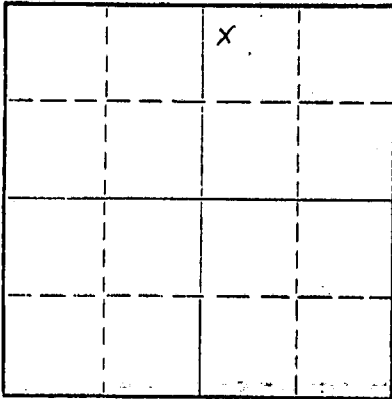

Locate well correctly on above
Section Plat

Graham County, Sec. 27 Twp. 8S Rge. (E) 24 (W)
Location as "NE/CNW%SW%" or footage from lines NW NW NE
Lease Owner Martin Exploration, Inc. & Abercrombie Drilling, Inc
Lease Name KOBLER Well No. 1
Office Address 801 Union Center; Wichita, Kansas
Character of Well (completed as Oil, Gas or Dry Hole) Dry Hole
Date well completed April 6, 1970
Application for plugging filed (Verbally) April 1, 1970
Application for plugging approved " April 1, 1970
Plugging commenced April 6, 1970
Plugging completed April 6, 1970
Reason for abandonment of well or producing formation Dry Hole

If a producing well is abandoned, date of last production _____ 19____
Was permission obtained from the Conservation Division or its agents before plugging was commenced? Yes

Name of Conservation Agent who supervised plugging of this well W. L. Nichols
Producing formation _____ Depth to top _____ Bottom _____ Total Depth of Well 3910 Feet
Show depth and thickness of all water, oil and gas formations.

OIL, GAS OR WATER RECORDS

CASING RECORD

FORMATION	CONTENT	FROM	TO	SIZE	PUT IN	PULLED OUT
				8-5/8"	201'	None
RECEIVED STATE CORPORATION COMMISSION MAY 4 1970 5-4-1970 CONSERVATION DIVISION Wichita, Kansas						

Describe in detail the manner in which the well was plugged, indicating where the mud fluid was placed and the method or methods used in introducing it into the hole. If cement or other plugs were used, state the character of same and depth placed, from _____ feet to _____ feet for each plug set.

Set 1st plug @ 1125' w/100 sx.
Set 2nd plug @ 215' w/20 sx.
Set top plug @ 40' w/10 sx.
Job completed 11:30 a.m., 4-6-70


(If additional description is necessary, use BACK of this sheet)

Name of Plugging Contractor Abercrombie Drilling, Inc.
Address 801 Union Center; Wichita, Kansas

STATE OF KANSAS, COUNTY OF SEDGWICK, ss.
Jerry A. Langrehr (employee of owner) or (owner or operator) of the above-described well, being first duly sworn on oath, says: That I have knowledge of the facts, statements, and matters herein contained and the log of the above-described well as filed and that the same are true and correct. So help me God.

(Signature) Jerry A. Langrehr
801 Union Center; Wichita, Kansas
(Address)

SUBSCRIBED AND SWORN to before me this 9th day of April, 19 70

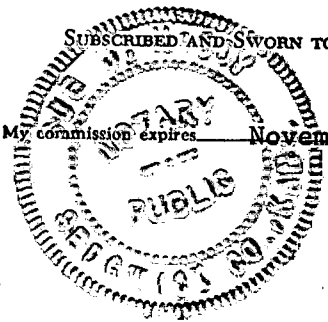

Sue J. McCoy
Sue J. McCoy
Notary Public.

CONTRACTOR'S WELL LOG

OPERATOR: Martin Exploration, Inc.
 WELL NAME: Abercrombie Drilling, Inc.
 LOCATION: Kobler #1
 NW NW NE, Sec. 27-8S-24W
 Graham County, Kansas
 GEOLOGIST: Robert Brooks
 DATE COMMENCED: March 25, 1970
 DATE COMPLETED: April 6, 1970

0	30	Rock
30	1000	Shale
1000	1125	Shale & Shells
1125	1300	Sand
1300	1500	Shale
1500	1813	Sand
1813	2057	Shale (Red)
2057	2086	Anhydrite
2086	2660	Shale
2660	3680	Lime & Shale
3680	3910	Lime
	3910	Rotary Total Depth

Drilled 210' of 12-1/4" surface hole and set 201' of 8-5/8", 20# csg. w/150 sx. Sunset cement. Cement circulated. Plug was down at 6:15 p.m., 3-25-70.
 Dry & Abandoned.

FORMATION SAMPLE TOPS	ELEVATION
T/Anhydrite 2057 (+ 280)	2337 K. B.
Topeka 3431 (-1094)	2335 D. F.
Heebner 3654 (-1317)	2329 G. L.
Toronto 3677 (-1340)	
Lansing 3692 (-1355)	
R. T. D. 3910 (-1573)	

RECEIVED
 STATE CORPORATION COMMISSION
 APR 10 1970
 CONSERVATION DIVISION
 Wichita, Kansas

4-10-1970

STATE OF KANSAS)
) SS
 COUNTY OF SEDGWICK)

Jerry A. Langrehr, president of Abercrombie Drilling, Inc., does hereby state that the above and foregoing is a true and correct copy of the log of the #1 Kobler, NW NW NE, Section 27-8S-24W, Graham County, Kansas.

ABERCROMBIE DRILLING, INC.

By: Jerry A. Langrehr
 Jerry A. Langrehr, President

Sworn to me, a Notary Public, in and for the county and state aforesaid, as of this 9th day of April, 1970.

Sue J. McCoy
 Sue J. McCoy, Notary Public

My Commission Expires: November 12, 1973