


WELL PLUGGING RECORD

Give All Information Completely
Make Required Affidavit

COUNTY GRAHAM SEC. 27 TWP. 8S RGE. 24W E/W
Location as in quarters or footage from lines:
C S/2 S/2 NW/4

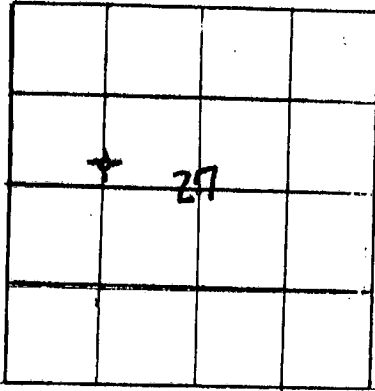

Lease Owner Thomas E. Black d/b/a Black Petroleum Company
Lease Name Anna Getty Well No. 1
Office Address 527 Union Center, Wichita, Kansas 67202
Character of Well (Completed as Oil, Gas or Dry Hole): dry hole
Date Well Completed July 14, 1983
Application for plugging filed July 14, 1983
Plugging commenced July 14, 1983
Plugging completed July 14, 1983
Reason for abandonment of well or producing formation dry hole

Locate Well
correctly on above
Section Platt.

Was permission obtained from the Conservation Division or it's
Agent's before plugging was commenced? Yes

Name of Conservation Agent who supervised plugging of this well Gilbert Scheck
Producing formation _____ Depth to top _____ bottom _____ T.D. 3957'
Show depth and thickness of all water, oil and gas formations.

OIL, GAS OR WATER RECORDS Casing Record

Formation	Content	From	To	Size	Put in	Pulled Out
		0	252'	8 5/8"	252'	-0-

Describe in detail the manner in which the well was plugged, indicating where the mud fluid was placed and the method or methods used in introducing it into the hold. If cement or other plugs were used, state the character of same and depth placed, from _____ feet to _____ feet for each plug set.

Plugged through drill pipe @ 2090' w/20 sx;
@1250' w/100 sx.; @ 300' w/ 40 sx., Bridge & 10 sx. @ 40';
10 sx. in rathole used 90 sx. Common class A; 90 sx. type F pozmix,
6% gel.

(If additional description is necessary, use BACK of this sheet)

Name of Plugging Contractor B. & B Drilling, Inc.

STATE OF KANSAS COUNTY OF SEDGWICK, ss.
Bill G. Lahar (employee of owner) or (owner or operator) of the
above-described well, being first duly sworn on oath, says: That I have knowledge of the
facts, statements, and matters herein contained and the log of the above-described well as
filed and that the same are true and correct. So help me God.


(Signature) Bill G. Lahar
515 Union Center, Wichita, Ks.
(Address)

SUBSCRIBED AND SWORN TO before me this 21st day of July, 19 83

My Commission expires: _____



Betty M. Abbott
Notary Public.

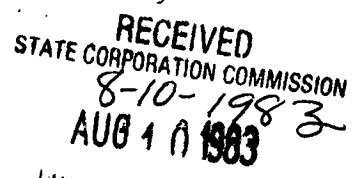

CONSERVATION DIVISION
Wichita, Kansas