

STATE OF KANSAS
STATE CORPORATION COMMISSION


Form CP-4

Give All Information Completely
Make Required Affidavit
Mail or Deliver Report to:
Conservation Division
State Corporation Commission
P. O. Box 17027
Wichita, Kansas 67217
NORTH

WELL PLUGGING RECORD

Graham County, Sec. 28 Twp. 8S Rge. (E) 24 (W)

Location as "NE/CNW/SW" or footage from lines SW SW NW
Lease Owner Cities Service Oil Company
Lease Name Holley North LKC Unit Well No. 101
Office Address Box 553 Russell, Kansas 67665
Character of Well (completed as Oil, Gas or Dry Hole) Oil
Date well completed 1-27 19 56
Application for plugging filed 10-12 19 71
Application for plugging approved 10-15 19 71
Plugging commenced 12-6 19 71
Plugging completed 12-16 19 71
Reason for abandonment of well or producing formation Depleted

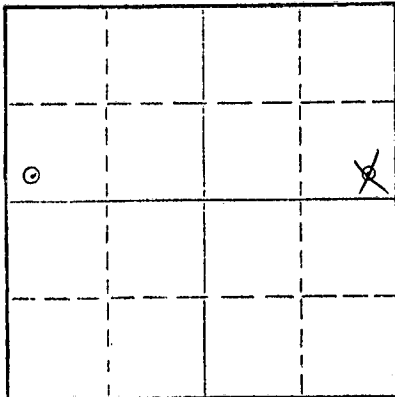

Locate well correctly on above
Section Plat

If a producing well is abandoned, date of last production September 19 70
Was permission obtained from the Conservation Division or its agents before plugging was commenced? Yes

Name of Conservation Agent who supervised plugging of this well Mr. W.L. Nichols
Producing formation Lansing-Kansas City Depth to top 3701' Bottom 3898 Total Depth of Well 3897 1/2 Feet
Show depth and thickness of all water, oil and gas formations.

OIL, GAS OR WATER RECORDS

CASING RECORD

FORMATION	CONTENT	FROM	TO	SIZE	PUT IN	PULLED OUT
				8 5/8"	225'	None
				5 1/2"	3888'	810'

Describe in detail the manner in which the well was plugged, indicating where the mud fluid was placed and the method or methods used in introducing it into the hole. If cement or other plugs were used, state the character of same and depth placed, from feet to feet for each plug set.

Checked bottom, drove 5 1/2" plug to 3500', dumped sand and rock on plug. Shot 5 1/2" casing 25 1499', 1306', 1111', 911', and 813' and pulled 25 joints. Halliburton pumped in 5 sx. hulls, 12 sx. gel, 110 cu. ft. cement 1150' to 825', 14 sx. gel 825', to 250', 30 cu. ft. cement 250' to 175', 4 sx. gel 175' to 25', and 6 cu. ft. cement 25' to surface.

RECEIVED
STATE CORPORATION COMMISSION
APR 13 1972
CONSERVATION DIVISION
Wichita, Kansas

(If additional description is necessary, use BACK of this sheet)

Name of Plugging Contractor Knight Casing Pulling Co., Inc.
Address Chase, Kansas

STATE OF Kansas, COUNTY OF Russell, ss.
E. W. Peterman (employee of owner) or (owner or operator) of the above-described well, being first duly sworn on oath, says: That I have knowledge of the facts, statements, and matters herein contained and the log of the above-described well as filed and that the same are true and correct. So help me God.

(Signature) E. W. Peterman

Box 553 Russell, Kansas 67665

(Address)

12th day of April, 19 72

James F. Kyger

Notary Public.

Subscribed and sworn to before me this 10-5-72
My commission expires

