

STATE OF KANSAS  
STATE CORPORATION COMMISSION

WELL PLUGGING RECORD

Give All Information Completely  
Make Required Affidavit  
Mail or Deliver Report to  
Conservation Division  
State Corporation Comm.  
245 North Water  
Wichita, KS 67202

Graham County, Sec. 28 Twp. 8S Rge. 24WE/W  
Location as "NE/CNW $\frac{1}{4}$ SW $\frac{1}{4}$ " or footage from lines \_\_\_\_\_

C NE NE NW  
Lease Owner Abercrombie Drilling, Inc.

Lease Name Schierkolk Well No. 1

Office Address 801 Union Center, Wichita, Kansas 67202

Character of Well (Completed as Oil, Gas or Dry Hole) \_\_\_\_\_  
Dry Hole

Date Well completed Jan. 19 1979

Application for plugging filed (verbally) Jan. 19 1979

Application for plugging approved (verbally) Jan. 19 1979

Plugging commenced Jan. 19 1979

Plugging completed Jan. 19 1979

Reason for abandonment of well or producing formation \_\_\_\_\_

No commercial quantity of oil or gas encountered.


If a producing well is abandoned, date of last production \_\_\_\_\_  
19

Was permission obtained from the Conservation Division or its agents before plugging was commenced? Yes

Name of Conservation Agent who supervised plugging of this well Gilbert Balthazor

Producing formation \_\_\_\_\_ Depth to top \_\_\_\_\_ Bottom \_\_\_\_\_ Total Depth of Well 3900'

Show depth and thickness of all water, oil and gas formations.

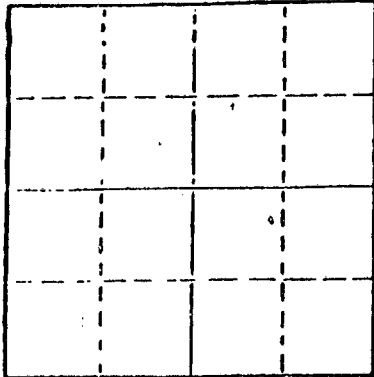

Locate well correctly on above Section Plat

OIL, GAS OR WATER RECORDS

CASING RECORD

FORMATION	CONTENT	FROM	TO	SIZE	PUT IN	PULLED OUT

Describe in detail the manner in which the well was plugged, indicating where the mud fluid was placed and the method or methods used in introducing it into the hold. If cement or other plugs were used, state the character of same and depth placed, from \_\_\_\_\_ feet to \_\_\_\_\_ feet for each plug set.

RECEIVED  
STATE CORPORATION COMMISSION

T.D. 3900'

Set 1st plug at 950' with 70 sacks

2nd plug at 240' with 20 sacks

3rd plug at 40' with 10 sacks

5 sacks in the rathole.

Cemented with 50/50 posmix, 6% gel.

Plug was down at 8:00 a.m., 1-19-79

JAN 26 1979

1-26-1979

CONSERVATION DIVISION  
Wichita, Kansas

(If additional description is necessary, use BACK of this sheet)

Name of Plugging Contractor Abercrombie Drilling, Inc.

STATE OF Kansas COUNTY OF Sedgwick, ss.

Jack L. Partridge, Asst. Sec.-Treas. (employee of owner) or (owner or operator) of the above-described well, being first duly sworn on oath, says: That I have knowledge of the facts, statements, and matters herein contained and the log of the above-described well as filed and that the same are true and correct. So help me God.



(Signature) Jack L. Partridge

801 Union Center, Wichita, Kansas 67202  
(Address)

SUBSCRIBED AND SWORN TO before me this 25th day of January, 19 79

Sherrie L. Brooks  
Sherrie L. Brooks Notary Public.

My commission expires 8-21-82