

WELL PLUGGING RECORD

STATE CORPORATION COMMISSION


Give All Information Completely
Make Required Affidavit
Mail or Deliver Report to:
Conservation Division
State Corporation Commission
211 No. Broadway
Wichita, Kansas

Graham

County. Sec. 29 Twp. 8 Rge. 24 (E) W (W)

Location as "NE/CNW/SW" or footage from lines NE NE SE
Lease Owner Morgenstern Oil Operations
Lease Name Keith Well No. 1
Office Address Wichita, Kansas
Character of Well (completed as Oil, Gas or Dry Hole) _____
Date well completed _____ 19____
Application for plugging filed _____ 19____
Application for plugging approved _____ 19____
Plugging commenced 2-8-62 19____
Plugging completed 2-15-62 19____
Reason for abandonment of well or producing formation Depleted.

NORTH

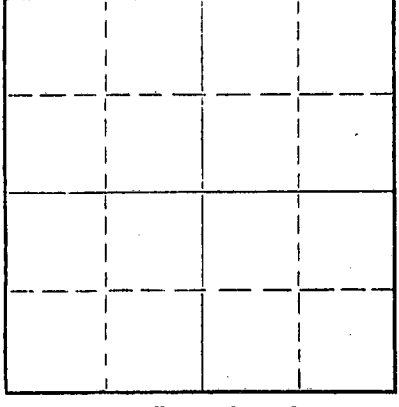

Locate well correctly on above Section Plat

If a producing well is abandoned, date of last production _____ 19____
Was permission obtained from the Conservation Division or its agents before plugging was commenced? yes

Name of Conservation Agent who supervised plugging of this well Eldon Petty
Producing formation _____ Depth to top _____ Bottom _____ Total Depth of Well 3947 Feet
Show depth and thickness of all water, oil and gas formations.

OIL, GAS OR WATER RECORDS

CASING RECORD

FORMATION	CONTENT	FROM	TO	SIZE	PUT IN	PULLED OUT
				8-5/8"	274'	None
				5-1/2"	3944'	1562'

Describe in detail the manner in which the well was plugged, indicating where the mud fluid was placed and the method or methods used in introducing it into the hole. If cement or other plugs were used, state the character of same and depth placed, from _____ feet to _____ feet for each plug set.

Checked hole to 3947', sanded to 3740' and dumped 4 sacks of cement @ 3740' with dump bailer. Pulled 5 1/2" casing to 550' and circulated pipe @ 550' with 29 sacks of mud and 20 sacks of cement. Pulled balance of 5 1/2" casing and ran 10 sacks of cement to base of cellar.

PLUGGING COMPLETE.

RECEIVED
STATE CORPORATION COMMISSION

MAR 13 1962
3-13-1962
CONSERVATION DIVISION
WICHITA, KANSAS

Name of Plugging Contractor KNIGHT CASING PULLING COMPANY (If additional description is necessary, use BACK of this sheet)
Address CHASE, KANSAS

STATE OF KANSAS COUNTY OF RICE, ss. Noel J. Knight (employee of owner) or (~~owner~~) of the above-described

well, being first duly sworn on oath, says: That I have knowledge of the facts, statements, and matters herein contained and the log of the above-described well as filed and that the same are true and correct. So help me God.

(Signature) Noel J. Knight
Chase, Kansas
(Address)

SUBSCRIBED AND SWORN TO before me this 26th day of February, 1962

My commission expires May 20, 1964 Milton J. Volin Notary Public.

