

STATE OF KANSAS
STATE CORPORATION COMMISSION


WELL PLUGGING RECORD

Give All Information Completely
Make Required Affidavit
Mail or Deliver Report to:
Conservation Division
State Corporation Commission
800 Biting Building
Wichita, Kansas

Graham County, Sec. 29 Twp. 8 Rge. 24 (E) (W)

Location as "NE/CNW $\frac{1}{4}$ /SW $\frac{1}{4}$ " or footage from lines NE NE SE
Lease Owner The El Dorado Refining Company
Lease Name Keith Well No. 3
Office Address Box 209 - Russell, Kansas
Character of Well (completed as Oil, Gas or Dry Hole) Dry Hole
Date well completed September 3 1956
Application for plugging filed September 17 1956
Application for plugging approved September 20 1956
Plugging commenced September 26 1956
Plugging completed October 4 1956
Reason for abandonment of well or producing formation Dry Hole

NORTH

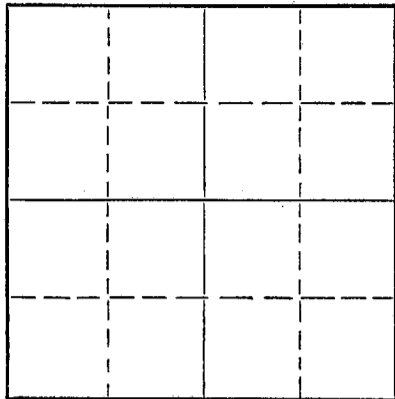

Locate well correctly on above
Section Flat

If a producing well is abandoned, date of last production - - - - - 19 - - -
Was permission obtained from the Conservation Division or its agents before plugging was commenced? yes

Name of Conservation Agent who supervised plugging of this well Mr. Eldon Petty - Box 326 Hays, Kansas
Producing formation Lansing D.C. (dry) Depth to top 3703' Bottom Total Depth of Well 3916 Feet
Show depth and thickness of all water, oil and gas formations.

OIL, GAS OR WATER RECORDS

CASING RECORD

Formation	Content	From	To	Size	Put In	Pulled Out
				8 5/8"	315'	None
				5 1/2"	3916'	3372.50'

Describe in detail the manner in which the well was plugged, indicating where the mud fluid was placed and the method or methods used in introducing it into the hole. If cement or other plugs were used, state the character of same and depth placed, from feet to feet for each plug set.

FILLED HOLE WITH SAND TO 3710'

RUN 4 SACKS OF CEMENT AT 3710'

MUDDER TO 310'

SET ROCK BRIDGE TO 300'

RUN 20 SACKS OF CEMENT AT 300'

MUDDER TO 35'

SET ROCK BRIDGE TO 30'

RUN 10 SACKS OF CEMENT TO CAP.

(If additional description is necessary, use BACK of this sheet)

Name of Plugging Contractor C. E. Shull Casing Pulling Company
Address Box 558 - Great Bend, Kansas

RECEIVED
STATE CORPORATION COMMISSION


STATE OF KANSAS, COUNTY OF RUSSELL
LEVI B. SHERMAN (employee of owner) or (owner/operator) of the above-described well,

being first duly sworn on oath, says: That I have knowledge of the facts, statements, and matters herein contained and the log of the above-described well as filed and that the same are true and correct. So help me God.

(Signature) Levi B. Sherman
Box 209 - Russell, Kansas
(Address)

SUBSCRIBED AND SWORN to before me this 15th day of October, 1956

My commission expires 10-2-60

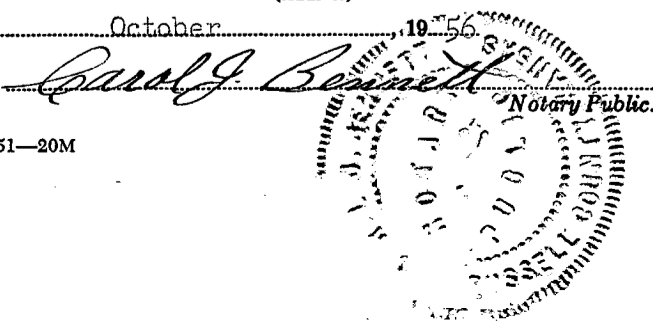

PLUGGING
FILE SEC 29 T 8 R 24W
BOOK PAGE 100 LINE 45

Petty

ROTARY DRILLING LOG

OPERATOR: El Borado Refining Company
Keith #3
NW NE SE Sec. 29-8-24W
Graham County, Kansas

CONTRACTOR: Prime Drilling Company
COMM: 8-21-56
COMP: 9-3-56

Remarks: Set 8 5/8" surface casing
at 315' cemented with 215 sacks common
cement and 2% C.C.

Formations:

Clay & Rock Posts	20'
Sand & Shale	70'
Shale & Shells	1235'
Sand & Shale	1420'
Shale & Shells	1615'
D.K. Sand	1835'
Red Bed	2085'
Anhydrite	2115'
Shale & Red Bed	2295'
Shale & Shells	2440'
Lime & Shale	3560'
Lime	3610'
Lime & Shale	3655'
Lime	3916'

Rotary Total Depth 3916'

Set 5 1/2" casing at 3916' cemented
with 150 sacks common cement

We certify the above log is true and
correct to the best of our knowledge
and belief.

PRIME DRILLING COMPANY

Perf. 3881-3887'
Plug: 3864'
Perf. 3840-3846'
Plug: 3796'
Perf: 3753-3759'

R. R. McNicol

FORMATION TOPS: Elevation 2370' DF

Heebner	3663
Toronto	3689
Lansing	3703 (-1330)
TD	3916' KB

10-9-1956

PLUGGING
SEC. 29 T. 8 R. 24W
PAGE 100 LINE 45