

STATE OF KANSAS
STATE CORPORATION COMMISSION

WELL PLUGGING RECORD

Give All Information Completely
Make Required Affidavit
Mail or Deliver Report to:
Conservation Division
State Corporation Commission
800 Bitting Building
Wichita, Kansas

Graham

County. Sec 29 Twp 8S Rge. 24W (E) (W)

Location as "NE/CNWxSWx" or footage from lines NE SW NE

Lease Owner Imperial Oil of Kansas, Inc.

Lease Name Graham Well No. 3

Office Address 903 Union National Bldg., Wichita 2, Kansas

Character of Well (completed as Oil, Gas or Dry Hole) Dry Hole

Date well completed February 2, 1957

Application for plugging filed February 2, 1957

Application for plugging approved February 2, 1957


Plugging commenced February 2, 1957

Plugging completed February 2, 1957

Reason for abandonment of well or producing formation No commercial quantities of oil found.

If a producing well is abandoned, date of last production 19

Was permission obtained from the Conservation Division or its agents before plugging was commenced? yes

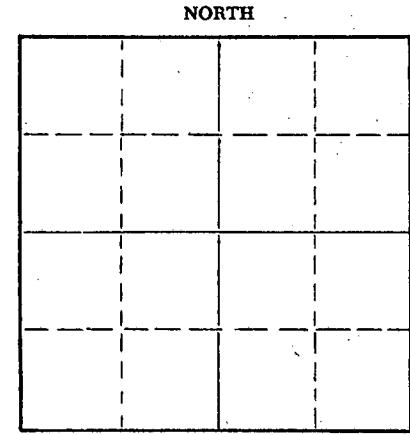

Locate well correctly on above Section Plat

Name of Conservation Agent who supervised plugging of this well Eldon Petty, Box 326, Hays, Kansas

Producing formation _____ Depth to top _____ Bottom _____ Total Depth of Well 3869 Feet

Show depth and thickness of all water, oil and gas formations.

OIL, GAS OR WATER RECORDS

CASING RECORD

FORMATION	CONTENT	FROM	TO	SIZE	PUT IN	PULLED OUT
				8-5/8"	2-2-57	

Describe in detail the manner in which the well was plugged, indicating where the mud fluid was placed and the method or methods used in introducing it into the hole. If cement or other plugs were used, state the character of same and depth placed, from _____ feet to _____ feet for each plug set.

Plugged hole with 15 sacks cement at 180 feet, 10 sacks cement from 40 feet to top.

RECEIVED
STATE CORPORATION COMMISSION

FEB 14 1957
2-14-1957
CONSERVATION DIVISION
Wichita, Kansas

Name of Plugging Contractor Imperial Oil of Kansas, Inc.
Address 903 Union National Bldg., Wichita 2, Kansas

STATE OF KANSAS, COUNTY OF SEDGWICK, ss.
Raymond L. Bacon (employee of owner) or (owner or operator) of the above-described well, being first duly sworn on oath, says: That I have knowledge of the facts, statements, and matters herein contained and the log of the above-described well as filed and that the same are true and correct. So help me God. IMPERIAL OIL OF KANSAS, INC.

(Signature) By: Raymond L. Bacon V-P
903 Union National Bldg., Wichita, Kansas
(Address)

SUBSCRIBED AND SWORN TO before me this 13th day of February, 19 57

Louetta M. Duncan
Notary Public.



PLUGGING
FILE SEC 29 T 8 R 24 W
BOOK PAGE 139 LINE 44

DRILLER'S LOG

Imperial Oil of Kansas, Inc.
903 Union National Building
Wichita 2, Kansas

Graham No. 3
NE SW NE Sec. 29-8S-24W
Graham County, Kansas

Total Depth: 3869'

Elevation: 2327'
Production: D & A

Commenced: 1-23-57 Completed: 2-2-57


Contractor: Imperial Oil of Kansas, Inc.
Wichita, Kansas

Casing Record: Set 8-5/8" Surface Pipe at 182' with 150 sacks cement.

Figures indicate bottom of formations:

Shale & Shells	875'		
Shale & Sand	950'		
Shale & Shells	1030'	Anhydrite	<u>TOPS</u> 2040' (/287)
Shale	1260'	Heebner	3624' (-1297)
Shale & Sand	1370'	Toronto	3645' (-1318)
Sand	1395'	Lansing	3663' (-1336)
Shale & Sand	1610'	Total Depth	3869' (-1542)
Sand	1790'		
Shale & Red Bed	2040'		
Anhydrite	2075'		
Shale & Shells	2730'		
Shale & Lime	2845'		
Shale	2985'		
Lime & Shale	3530'		
Lime	3869'		
Total Depth	3869'		

We hereby certify this to be a correct and accurate log of the above described well as shown on the daily drilling reports.

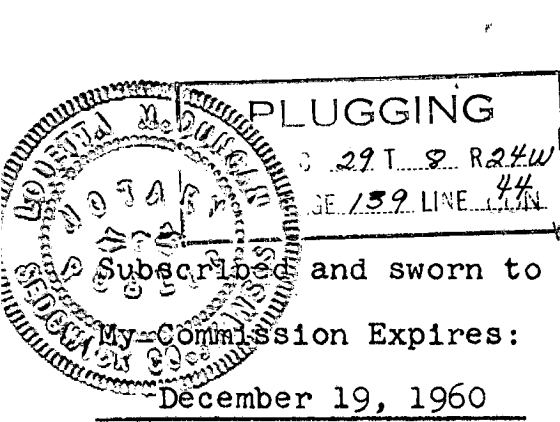

VED
IN COMMISSION
2-14-1957
FEB 14 1957
REGISTRATION DIVISION
Wichita, Kansas

IMPERIAL OIL OF KANSAS, INC.

By: Ray L. Bacon
Vice-President

Subscribed and sworn to before me this 13th day of February, 1957.

My Commission Expires:
December 19, 1960

Louella M. Duncan
Notary Public