


STATE OF KANSAS  
STATE CORPORATION COMMISSION

WELL PLUGGING RECORD

Give All Information Completely  
Make Required Affidavit  
Mail or Deliver Report to  
Conservation Division  
State Corporation Comm.  
245 North Water  
Wichita, KS 67202

Graham County. Sec. 29 Twp. 8S Rge. 24W ~~E7W~~  
Location as "NE/CNW $\frac{1}{4}$ /SW $\frac{1}{4}$ " or footage from lines  
C NW SE NW

Lease Owner George R. Jones  
Lease Name Keith Well No. 1  
Office Address 125 N. Market, Suite 1210, Wichita, KS 67202  
Character of Well (Completed as Oil, Gas or Dry Hole)

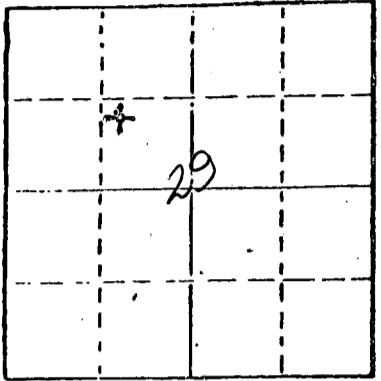

Locate well correctly on above  
Section Plat

Dry Hole  
Date Well completed August 30, 1983 19  
Application for plugging filed August 30, 1983 (verbal) 19  
Application for plugging approved August 30, 1983 19  
Plugging commenced August 30, 1983 19  
Plugging completed August 30, 1983 19  
Reason for abandonment of well or producing formation  
dry hole

If a producing well is abandoned, date of last production 19

Was permission obtained from the Conservation Division or  
its agents before plugging was commenced? Yes

Name of Conservation Agent who supervised plugging of this well Carl Goodrow  
Producing formation Depth to top Bottom Total Depth of Well  
Show depth and thickness of all water, oil and gas formations.

OIL, GAS OR WATER RECORDS

CASING RECORD

FORMATION	CONTENT	FROM	TO	SIZE	PUT IN	PULLED OUT
		Ran 8 jts.	8-5/8"	set at	324.45'	180 sx
		Common,	2% gel,	3% c.c.		

Describe in detail the manner in which the well was plugged, indicating where the mud fluid  
was placed and the method or methods used in introducing it into the hold. If cement or other  
plugs were used, state the character of same and depth placed, from feet to  
feet for each plug set.

- 1st plug @ 2100' 20 sx
- 2nd plug @ 1200' 100 sx
- 3rd plug @ 325' 40 sx
- 4th plug @ 40' solid bridge, 10 sx
- 10 sx in rathole
- Cement: 50-50 Posmix, 6% gel, 3% c.c.

(If additional description is necessary, use BACK of this sheet)

Name of Plugging Contractor Halliburton Services

STATE OF KANSAS COUNTY OF SEDGWICK, ss.  
George R. Jones (employee of owner) or (owner or operator)

of the above-described well, being first duly sworn on oath, says: That I have knowledge of  
the facts, statements, and matters herein contained and the log of the above-described well  
as filed and that the same are true and correct. So help me God.

(Signature) *George R. Jones*  
125 N. Market, Suite 1210, Wichita, KS 67202  
(Address)

SUBSCRIBED AND SWORN TO before me this 30th day of August, 19 83

*Wilma E. Clark*  
Notary Public.

My commission expires August 5, 1984

