

15-065-00709-0000

STATE OF KANSAS
STATE CORPORATION COMMISSION

WELL PLUGGING RECORD

Give All Information Completely
Make Required Affidavit
Mail or Deliver Report to:
Conservation Division
State Corporation Commission
800 Bitting Building
Wichita, Kansas

Graham County, Sec. 28 Twp. 8 Rge. 23 (E) W (W)

Location as "NE/CNW&SW" or footage from lines NW, NW, NW

Lease Owner Leonard Isern Oil Co.

Lease Name Funk Well No. 1

Office Address Rule Building, Wichita, Kansas

Character of Well (completed as Oil, Gas or Dry Hole) Dry -

Date well completed 1-18 19 55

Application for plugging filed 1-18 19 55

Application for plugging approved 1-18 19 55


Plugging commenced 1-19 19 55

Plugging completed 1-19 19 55

Reason for abandonment of well or producing formation Dry

If a producing well is abandoned, date of last production 19

Was permission obtained from the Conservation Division or its agents before plugging was commenced? yes

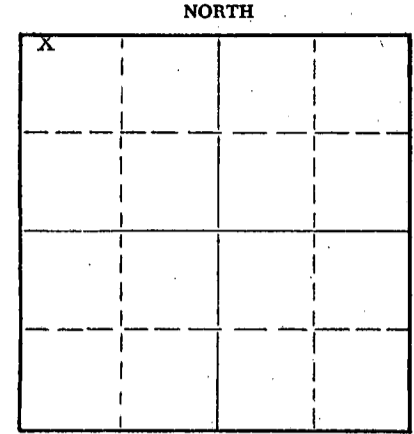

Locate well correctly on above Section Plat

Name of Conservation Agent who supervised plugging of this well Eldon Peddy

Producing formation None Depth to top Bottom Total Depth of Well 4110 Feet

Show depth and thickness of all water, oil and gas formations.

OIL, GAS OR WATER RECORDS

CASING RECORD

FORMATION	CONTENT	FROM	TO	SIZE	PUT IN	PULLED OUT
				8 5/8	146'	None

Describe in detail the manner in which the well was plugged, indicating where the mud fluid was placed and the method or methods used in introducing it into the hole. If cement or other plugs were used, state the character of same and depth placed, from feet to feet for each plug set.

Hole was filled with heavy mud to 180 feet. Plug was set and 15 sacks of cement was hand mixed and placed on top of plug through drill pipe. Hole was then filled to 40 feet with heavy mud and plug was set at 40 foot and 10 sacks was hand mixed and put on top of plug.

STATE OF KANSAS
JAN 27
CONSERVATION DIVISION

2-21-55

(If additional description is necessary, use BACK of this sheet)

Name of Plugging Contractor Schafer Drilling Co.

Address Peoples Bank Bldg., Pratt, Kansas


STATE OF Kansas, COUNTY OF Pratt, ss.

(employee of owner) or (owner or operator) of the above-described well, being first duly sworn on oath, says: That I have knowledge of the facts, statements, and matters herein contained and the log of the above-described well as filed and that the same are true and correct. So help me God.

(Signature) J. Selby
Pratt, ks (Address)

SUBSCRIBED AND SWORN TO before me this 20th day of January, 1955

My commission expires June 30, 1955
Maude B McBride Notary Public.

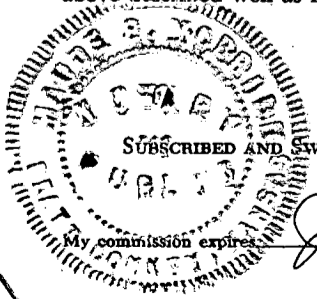

PLUGGING
FILE SEC 28 Twp 8 R 33N
BOOK PAGE 22 LINE 9

15-065-00709-00-00

DRILLERS LOG ----- FUNK #1 _____ GRAHAM COUNTY, KANSAS

0-142	Shale
142-755	Clay Shale
755-1275	Shale and Shells
1275-1300	Anhydrite
1300-1360	Shale and Shells
1360-1700	Shale, Shells & Sand
1700-1915	Shale and Shells
1915-1945	Anhydrite
1945-2265	Shale and Shells
2265-2310	Shale and Lime
2310-2400	Red Bed
2400-2925	Shale and Lime
2925-3185	Shale, Lime and Red Bed
3185-4110	Shale and Lime
4110	TOTAL DEPTH .

I certify that the above drillers log is true and correct as taken directly from the daily drilling reports of the Funk #1.

J. Kelly
Schafer Drilling Co.

State of Kansas: County of Pratt: SS

The above was subscribed and sworn to before me this 20 day of Jan 1955.

Maudie B McBride
Notary Public

My commission expires June 30, 1955.



PLUGGING
 FILE SEC 28 T 8 R 33N
 BOOK PAGE 92 LINE 9