

15-065-00718-00-00


STATE OF KANSAS  
STATE CORPORATION COMMISSION

WELL PLUGGING RECORD

Give All Information Completely  
Make Required Affidavit  
Mail or Deliver Report to:  
Conservation Division  
State Corporation Commission  
800 Bitting Building  
Wichita, Kansas

Graham County. Sec. 30 Twp. 8 Rge. 23 (E) W (W)  
Location as "NE/CNW/SW" or footage from lines SW SW SW  
Lease Owner C-G DRILLING CO. - D. G. HANSEN  
Lease Name Gaylord Well No. I  
Office Address 107 Rule Bldg., Wichita, Kansas  
Character of Well (completed as Oil, Gas or Dry Hole) dry hole  
Date well completed July 11, 19 55  
Application for plugging filed July 11, 19 55  
Application for plugging approved July 11, 19 55  
Plugging commenced July 11, 19 55  
Plugging completed July 11, 19 55  
Reason for abandonment of well or producing formation Too low structurally

NORTH

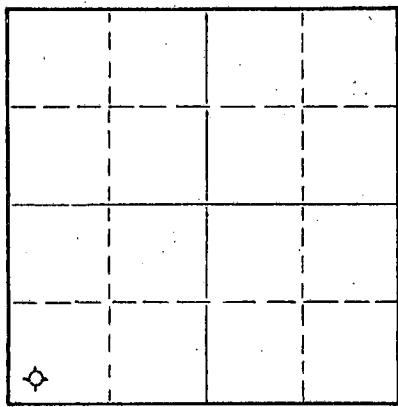

Locate well correctly on above  
Section Plat

If a producing well is abandoned, date of last production \_\_\_\_\_ 19\_\_\_\_  
Was permission obtained from the Conservation Division or its agents before plugging was commenced? Yes

Name of Conservation Agent who supervised plugging of this well Eldon Petty, Hays, Kansas  
Producing formation \_\_\_\_\_ Depth to top \_\_\_\_\_ Bottom \_\_\_\_\_ Total Depth of Well \_\_\_\_\_ Feet  
Show depth and thickness of all water, oil and gas formations.

OIL, GAS OR WATER RECORDS

CASING RECORD

FORMATION	CONTENT	FROM	TO	SIZE	PUT IN	PULLED OUT
				8-5/8"	295.08'	none

Describe in detail the manner in which the well was plugged, indicating where the mud fluid was placed and the method or methods used in introducing it into the hole. If cement or other plugs were used, state the character of same and depth placed, from \_\_\_\_\_ feet to \_\_\_\_\_ feet for each plug set.

Filled hole with heavy mud to 285'. Set plug.  
Put in 1/2 sack hulls and 15 sacks of cement.  
Filled with heavy mud up to 40'. Set plug.  
Filled to top with 1/2 sack hulls and 10 sacks cement.

RECEIVED  
STATE CORPORATION COMMISSION  
JUL 16 1955  
CONSERVATION DIVISION  
WICHITA, KANSAS

(If additional description is necessary, use BACK of this sheet)  
Name of Plugging Contractor C G DRILLING CO. 7-16-55  
Address 107 Rule Bldg., Wichita, Kansas

STATE OF KANSAS, COUNTY OF SEDGWICK, ss.  
JAY H. GALLOWAY (employee of owner) or (owner or operator) of the above-described well, being first duly sworn on oath, says: That I have knowledge of the facts, statements, and matters herein contained and the log of the above-described well as filed and that the same are true and correct. So help me God.

(Signature) Jay H. Galloway  
107 Rule Bldg., Wichita, Kansas  
(Address)



SUBSCRIBED AND SWORN to before me this 14th day of July, 19 55  
Vicky Jacobs  
Notary Public.

PLUGGING  
FILE SEC. 30 T. 8 R. 23W  
BOOK PAGE 125 LINE 4

15-065-00718-00-00

CONTRACTOR'S WELL LOG

OPERATOR C-G DRILLING CO. & D. G. HANSEN WELL NAME GAYLORD #1

WELL LOCATION SW/4 SW/4 SW/4 Sec. 30-8-23W

POOL NAME WILDCAT COUNTY GRAHAM STATE KANSAS

COMMENCEMENT DATE June 29, 1955 COMPLETION DATE July 11, 1955

LOG OF WELL

Elevation 2345 Rotary Bushing  
All measurements from the top of rotary bushing.

FROM	TO	FORMATION	DEVIATION FROM VERTICAL	REMARKS:
0	295	Shale-Sand		
295	350	Shale		
350	1470	Shale-Sand		
1470	1610	Sand-Shale		
1610	1800	Sand		
1800	2033	Red Bed		
2033	2073	Anhydrite		
2073	2325	Lime-Shale		
2325	2510	Lime-Shale		
2510	2655	lime-Shale		
2655	2715	Lime-Shale		
2715	2890	Lime-Shale	0° - 2750'	
2890	3010	Lime-Shale	0° - 3000'	
3010	3145	Lime-Shale		
3145	3265	Lime-Shale		
3265	3375	Lime-Shale		
3375	3455	Lime-Shale		
3455	3540	Lime-Shale		
3540	3620	Lime-Shale	0° - 3500'	
3620	3688	Lime-Shale		
3688	3730	Lime-Shale	0° - 3750'	DST 3735-3750'
3730	3750	Lime-Shale		DST 3758-3776'
3750	3776	Lime-Shale		
3776	3790	Lime-Shale		
3790	3836	Lime-Shale		DST 3820-3856'
3836	3860	Lime-Shale		DST 3856-3870'
3860	3870	Lime-Shale		
3870	3935	Lime-Shale		
3935	3990	Lime-Shale		
3990	4045	Lime-Shale	0° - 4000'	
4045	4085	Lime-Shale		
4085	4150	Lime-Shale		
4150	4203	Lime-Shale		
4203	4260	Lime-Shale		
4260	4272	Lime-Shale		

FILED 7-16-55


Ran Electric Log  
CORRELATION DIVISION  
Wichita, Kansas

CASING LEFT IN HOLE AFTER COMPLETION

Set 295.08' (14 jts.) 8-5/8" OD Surface Casing.

STATE OF KANSAS, COUNTY OF SEDGWICK ) ss.

The undersigned certifies that to the best of his knowledge and belief, the above facts are true and correct.

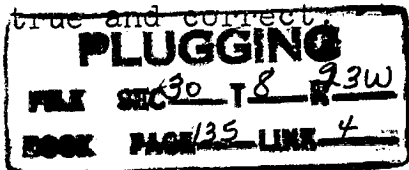

C-G DRILLING CO.

By Jay H. Galloway  
Jay H. Galloway



Vicki Jacobs  
Notary Public

My commission expires: May 20, 1959