

15-065-21074-00-00


STATE OF KANSAS
STATE CORPORATION COMMISSION

WELL PLUGGING RECORD

Give All Information Completely
Make Required Affidavit
Mail or Deliver Report to
Conservation Division
State Corporation Comm.
245 North Water
Wichita, KS 67202

Graham County, Sec. 31 Twp. 8S Rge. 23 E/W
Location as "NE/CNW $\frac{1}{4}$ SW $\frac{1}{4}$ " or footage from lines
SE NE

Lease Owner Voyager Petroleum Inc
Lease Name Brassfield Well No. 1
Office Address C/O Godsey Earlougher 6600 S Yale, Tulsa
Character of Well (Completed as Oil, Gas or Dry Hole) DRY HOLE OK

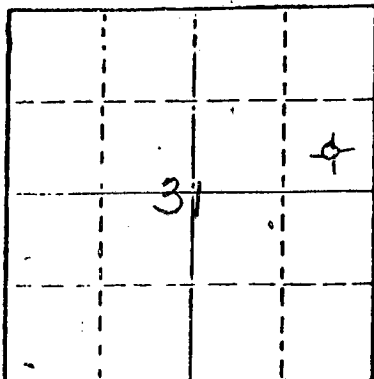

Locate well correctly on above
Section Plot

Date Well completed 11/21/78 19
Application for plugging filed 11/21/78 19
Application for plugging approved 11/21/78 19
Plugging commenced 11/21/78 19
Plugging completed 11/21/78 19
Reason for abandonment of well or producing formation
Too low structurally

If a producing well is abandoned, date of last production 19

Was permission obtained from the Conservation Division or
its agents before plugging was commenced? Yes

Name of Conservation Agent who supervised plugging of this well Gilbert Balthazor
Producing formation _____ Depth to top _____ Bottom _____ Total Depth of Well 4280'
Show depth and thickness of all water, oil and gas formations.

OIL, GAS OR WATER RECORDS

CASING RECORD

FORMATION	CONTENT	FROM	TO	SIZE	PUT IN	PULLED OUT
				8 5/8"	252.60	None

Describe in detail the manner in which the well was plugged, indicating where the mud fluid
was placed and the method or methods used in introducing it into the hold. If cement or other
plugs were used, state the character of same and depth placed, from _____ feet to
_____ feet for each plug set.

Filled with heavy mud to 980'. Set
Plug. Put in 70 sacks cement. Filled
with heavy mud to 240'. Set Plug.
Put in 20 sacks cement. Filled with
heavy mud to 40'. Set plug. Filled
to top with 10 sacks 50-50 pozmix,
6% Gel.

RECEIVED
STATE CORPORATION COMMISSION
NOV 29 1978
CONSERVATION DIVISION
Wichita, Kansas

(If additional description is necessary, use BACK of this sheet)

Name of Plugging Contractor C-G DRILLING CO., INC.

11-29-78

STATE OF KANSAS COUNTY OF SEDGWICK, ss.
G F GALLOWAY (employee of owner) or (owner or operator)
of the above-described well, being first duly sworn on oath, says: That I have knowledge of
the facts, statements, and matters herein contained and the log of the above-described well
as filed and that the same are true and correct. So help me God.

(Signature)

G F Galloway
G. F. Galloway
1107 Douglas Bldg.
Wichita, KS 67202 (Address)

SUBSCRIBED AND SWORN TO before me this 27th day of November, 1978

Debra L Heersche
Debra L Heersche Notary Public.

My commission expires March 3, 1980

