


STATE OF KANSAS
STATE CORPORATION COMMISSION

Give All Information Completely
Make Required Affidavit
Mail or Deliver Report to:
Conservation Division
State Corporation Commission
800 Bitting Building
Wichita, Kansas

15-045-00400-00-00
WELL PLUGGING RECORD

NORTH

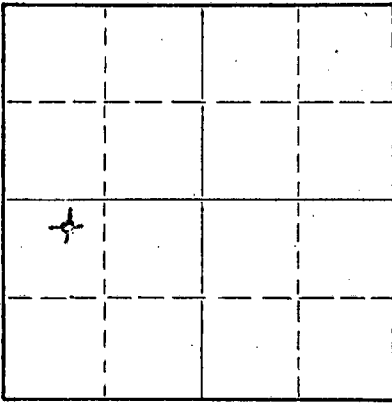

Locate well correctly on above Section Plat

Graham County. Sec. 1 Twp. 8S Rge. 24 (E) W (W)
Location as "NE/CNW&SW¼" or footage from lines NE NW SW
Lease Owner Peel+Hardman Oil Producers
Lease Name Lyon Well No. 1
Office Address P.O. Box 359, Hoisington, Kansas
Character of Well (completed as Oil, Gas or Dry Hole) Dry Hole
Date well completed Nov. 29 1954
Application for plugging filed Nov. 29 1954
Application for plugging approved Nov. 29 1954
Plugging commenced Nov. 29 1954
Plugging completed Nov. 29 1954
Reason for abandonment of well or producing formation Dry Hole

If a producing well is abandoned, date of last production _____ 19____
Was permission obtained from the Conservation Division or its agents before plugging was commenced? Yes

Name of Conservation Agent who supervised plugging of this well Eldon Petty
Producing formation _____ Depth to top _____ Bottom _____ Total Depth of Well 3855 Feet
Show depth and thickness of all water, oil and gas formations.

OIL, GAS OR WATER RECORDS

CASING RECORD

FORMATION	CONTENT	FROM	TO	SIZE	PUT IN	PULLED OUT
		0	147'	8 5/8"	147'	None

Describe in detail the manner in which the well was plugged, indicating where the mud fluid was placed and the method or methods used in introducing it into the hole. If cement or other plugs were used, state the character of same and depth placed, from _____ feet to _____ feet for each plug set.

From 3855' to 146½' - heavy rotary mud
146½' to 145' - wooden plug
145' to 99' - 15 sacks cement and 1/2 sack hulls
99' to 41½' - heavy rotary mud
41½' to 40' - wooden plug
40' to 6' - 10 sacks cement and 1/2 sack hulls
6' to surface - cellar

(If additional description is necessary, use BACK of this sheet)

Name of Plugging Contractor Glenn W. Peel
Address P.O. Box 359, Hoisington, Kansas

STATE OF KANSAS, COUNTY OF BARTON, ss.

Glenn W. Peel (employee of owner) or (owner or operator) of the above-described well, being first duly sworn on oath, says: That I have knowledge of the facts, statements, and matters herein contained and the log of the above-described well as filed and that the same are true and correct. So help me God. GLENN W. PEEL

(Signature) BY: [Signature]
P.O. Box 359, Hoisington, Kansas
(Address)

SUBSCRIBED AND SWORN to before me this 30th day of November, 1954

My commission expires June 4, 1955

Notary Public.

12/1/54 pend

PLUGGING
FILE SEC 1 T 8 R 74
BOOK PAGE 81 LINE 5

DRILLERS' LOG

Company: Peel-Hardman Oil Producers

NE NW SW

Farm Name: Lyon Well No. 1

Sec. 1, Twp. 8S, Rge. 24W,

Total Depth: 3855'

County: Graham,
Kansas

Comm: 11-20-54 Comp: 11-29-54
Contractor: Glenn W. Peel

Elevation:

Casing: 8 5/8" 147' cem.

Production: Dry

Figures below indicate bottoms of formations:

Surface soils	0 -	149
Shale		700
Shale and sand		1780
Shale and shells		2030
Anhydrite		2065
Shale		2310
Shale and shells		2500
Shale and Lime		2840
Lime		3140
Lime and shale		3260
Lime		3405
Lime and shale		3530
Lime		3855
Total Depth		3855

This is to certify that the above information is to the best of our knowledge, true and correct.

GLENN W. PEEL

BY: *Glenn W. Peel*

SUBSCRIBED AND SWORN to before me this 20th day of November, 1954.

My commission expires: June 4, 1955

Marian M. Herbert

Notary Public

PLUGGING
1-8 R24W
PAGE 81 LINE 5