


STATE OF KANSAS
STATE CORPORATION COMMISSION
Give All Information Completely
Make Required Affidavit
Mail or Deliver Report to:
Conservation Division
State Corporation Commission
212 No. Market
Wichita, Kansas

WELL PLUGGING RECORD

Graham County, Sec. 1 Twp. 8S Rge. 24 (E) (W) x

Location as "NE/CNW/SW" or footage from lines E/2 SE/4 NE/4
Lease Owner Meltzer Oil Company
Lease Name Hutton Well No. 1
Office Address Drawer B Great Bend, KS 67530
Character of Well (completed as Oil, Gas or Dry Hole) Oil
Date well completed 1/14 19.63
Application for plugging filed 4/29 19.82
Application for plugging approved 5/12 19.82
Plugging commenced 5/10 19.82
Plugging completed 5/10 19.82
Reason for abandonment of well or producing formation Dakota leak and depletion

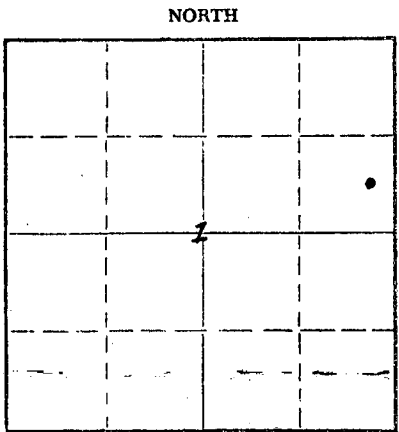

Locate well correctly on above Section Plat

If a producing well is abandoned, date of last production 3/29 19.82
Was permission obtained from the Conservation Division or its agents before plugging was commenced? Yes

Name of Conservation Agent who supervised plugging of this well Dennis Hamel
Producing formation Kansas City Depth to top 3579 Bottom 3788 Total Depth of Well 4060 Feet
Show depth and thickness of all water, oil and gas formations. P.B. 3764

OIL, GAS OR WATER RECORDS

CASING RECORD

FORMATION	CONTENT	FROM	TO	SIZE	PUT IN	PULLED OUT
				8 5/8"	210	None
				5 1/2"	3838	None

Describe in detail the manner in which the well was plugged, indicating where the mud fluid was placed and the method or methods used in introducing it into the hole. If cement or other plugs were used, state the character of same and depth placed, from feet to feet for each plug set.

Mixed 3 sx cottonseed hulls=150 sx 50/50 pozmix cement 6% gel 3% c.c. with 2 sx hulls. Pumped down 5 1/2" casing. Let set. Then came back, mixed 40 sx cement with 1 sx hulls down 5 1/2" casing and shut in at 700#.
Mixed 95 sx cement with 2 sx hulls. Pumped down 8-5/8" casing. Shut in at 1000#.

RECEIVED
STATE CORPORATION COMMISSION
MAY 27 1982
CONSERVATION DIVISION
Wichita, Kansas
5/27/82

Name of Plugging Contractor None
Address

STATE OF Kansas, COUNTY OF Barton, ss.
Oscar W. Temps (employee of owner) or (owner or operator) of the above-described well, being first duly sworn on oath, says: That I have knowledge of the facts, statements, and matters herein contained and the log of the above-described well as filed and that the same are true and correct. So help me God.

(Signature) Oscar W Temps
P.O. Drawer B Great Bend, KS 67530
(Address)

SUBSCRIBED AND SWORN to before me this 24th day of May, 1982
My commission expires
Notary Public.



15-065-00593-0000

RECEIVED
STATE CORPORATION COMMISSION

MAY - 4 1982

DRILLER'S LOG

CONSERVATION DIVISION
Wichita, Kansas

5/4/82

COMPANY:
CONTRACTOR:
FARM:
LOCATION:

COMMENCED:
COMPLETED:

LEBEN DRILLING, INC.
LEBEN DRILLING, INC.
HUTTON #1
SE $\frac{1}{4}$ SE $\frac{1}{4}$ NE $\frac{1}{4}$ SEC. 1-8S-24W
GRAHAM COUNTY, KANSAS
5-6-58
5-19-58

			LOG TOPS:
0	805	Shale	
805	1400	Shale & Shells	Anhydrite 1983
1400	1545	Shale & Lime	Heebner 3540
1545	1690	Sand	Lansing 3579
1690	1715	Shale & Sand	Bs. K.C. 3788
1715	1983	Shale & Redbed	Marmaton 3890
1983	1985	Anhydrite	Conglomerate 3978
1985	2018	Anhydrite	
2018	2135	Shale & Shells	
2135	2435	Shale	
2435	2730	Shale & Lime	
2730	2800	Lime & Shale	
2800	2960	Shale & Shells	
2960	3245	Lime & Shale	
3245	3360	Shale & Lime	
3360	3578	Lime & Shale	
3578	3650	Lime	
3650	3820	Lime	
3820	3955	Lime & Shale	
3955	4005	Shale	
4005	4060	Shale & Chert	
	4060	Rotary Total Depth	

Set 210' of 8 5/8" surface casing with 100 sacks cement.

I, Frank Hamlin, do hereby certify that the above and foregoing is a true and correct copy of the log of the Hutton #1, located SE $\frac{1}{4}$ SE $\frac{1}{4}$ NE $\frac{1}{4}$ of Section 1, Township 8 South, Range 24 West, Graham County, Kansas, as reflected by the files of Leben Drilling, Inc.

LEBEN DRILLING, INC.

By: Frank Hamlin
Frank Hamlin

STATE OF KANSAS)
COUNTY OF SEDGWICK) ss:

Subscribed and sworn to before me, a Notary Public, in and for Sedgwick County, Kansas, this 26th day of May, 1958.

Ruth N. Benjamin
Ruth N. Benjamin, Notary Public

My Commission Expires:
June 17, 1961