


15-065-02007-00-00

Give All Information Completely  
Make Required Affidavit  
Mail or Deliver Report to:  
Conservation Division  
State Corporation Commission  
211 No. Broadway  
Wichita, Kansas

WELL PLUGGING RECORD

NORTH

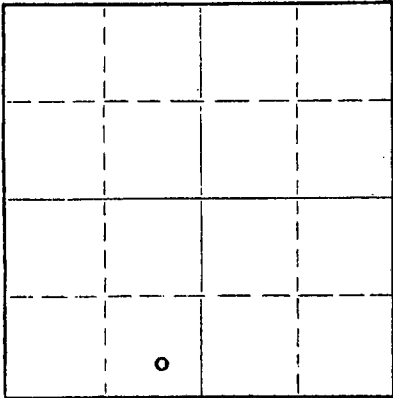

Locate well correctly on above Section Plat

Graham County. Sec. 1 Twp. 8S Rge. 24W (E) (W)  
Location as "NE/CNWxSWx" or footage from lines. SE SE SW  
Lease Owner Abercrombie Drilling, Inc.  
Lease Name Hardman Well No. 1  
Office Address 801 Union Center, Wichita, Kansas  
Character of Well (completed as Oil, Gas or Dry Hole) Dry Hole  
Date well completed December 29 19 63  
Application for plugging filed December 30 19 63  
Application for plugging approved December 30 19 63  
Plugging commenced December 30 19 63  
Plugging completed December 30 19 63  
Reason for abandonment of well or producing formation Dry Hole

If a producing well is abandoned, date of last production \_\_\_\_\_ 19\_\_\_\_  
Was permission obtained from the Conservation Division or its agents before plugging was commenced? Yes

Name of Conservation Agent who supervised plugging of this well W. L. Nichols, Moreland, Kansas  
Producing formation \_\_\_\_\_ Depth to top \_\_\_\_\_ Bottom \_\_\_\_\_ Total Depth of Well \_\_\_\_\_ Feet  
Show depth and thickness of all water, oil and gas formations.

OIL, GAS OR WATER RECORDS

CASING RECORD

FORMATION	CONTENT	FROM	TO	SIZE	PUT IN	PULLED OUT
		0	161'	8 5/8"	161'	none

Describe in detail the manner in which the well was plugged, indicating where the mud fluid was placed and the method or methods used in introducing it into the hole. If cement or other plugs were used, state the character of same and depth placed, from \_\_\_\_\_ feet to \_\_\_\_\_ feet for each plug set.

Set Plug 540' /20 sacks cement  
Plug 150' /20 sacks cement & 1/4 sack hulls  
Plug 40' /10 sacks cement & 1/4 sack hulls

RECEIVED  
STATE CORPORATION COMMISSION

JAN 8 1964

1/8/64

CONSERVATION DIVISION  
Wichita, Kansas

(If additional description is necessary, use BACK of this sheet)  
Name of Plugging Contractor Hellar Drilling Company, Inc.  
Address 1014 Union Center, Wichita, Kansas


STATE OF Kansas COUNTY OF Sedgwick, ss.  
D. L. Hellar, Pres. of Hellar Drig. Co. Inc. (employee of owner) or (owner or operator) of the above-described well, being first duly sworn on oath, says: That I have knowledge of the facts, statements, and matters herein contained and the log of the above-described well as filed and that the same are true and correct. So help me God.

(Signature) D. L. Hellar D. L. Hellar, President  
1014 Union Center, Wichita, Kansas  
(Address)

SUBSCRIBED AND SWORN to before me this 7th day of January, 19 64

My commission expires March 25, 1964

Catherine Darcey  
Catherine Darcey - - Notary Public.

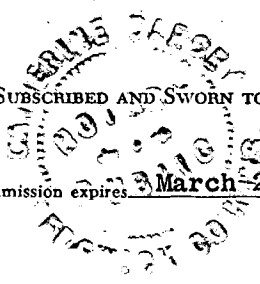

15-045-02007-0000

DRILLER'S LOG

COMPANY: Abercrombie Drilling, Inc.  
 CONTRACTOR: Hellar Drilling Company, Inc.  
 LEASE: #1 Hardman  
 LOCATION: SE SE SW 1-8S-24W, Graham County, Kansas  
 COMMENCED: December 17, 1963  
 COMPLETED: December 29, 1963  
 CASING: Set 8 5/8" surface casing @ 161'/135 sacks cement

0-161	Sand-shale-shells
161-910	Shale-shell
910-1645	Shale
1645-1980	Shale-sand
1980-2015	Anhydrite
2015-2185	Shale-Lime streaks
2185-2350	Shale-shells
2350-2490	Lime & shale
2490-2870	Shale & lime
2870-3115	Lime
3115-3218	Shale & Lime
3218-3472	Lime & shale
3472-3490	Shale & shells
3490-3605	Shale & lime
3605-3790	Lime
3790-3820	Lime & shale
3820	Rotary Total Depth
	Dry & Abandoned

RECEIVED  
STATE CORPORATION COMMISSION

JAN 8 1964

CONSERVATION DIVISION  
WICHITA, KANSAS

1/8/64

STATE OF KANSAS )  
 ) SS  
 COUNTY OF SEDGWICK )

I, D. L. Hellar, do hereby certify that the above and foregoing is a true and correct copy of the log of the #1 Hardman, located in SE SE SW 1-8S-24W, Graham County, Kansas, as reflected by the files of the Hellar Drilling Company, Inc.

HELLAR DRILLING COMPANY, INC.

By *D. L. Hellar*  
 President - D. L. Hellar

Subscribed and sworn to before me, a Notary Public, in and for Sedgwick County, Kansas, this 7th day of January 1964.

My Commission Expires: March 25, 1964.

*Catherine Darcy*  
 Notary Public - Catherine Darcy