


15-065-00779-00-00

WELL PLUGGING RECORD

Give All Information Completely
Make Required Affidavit
Mail or Deliver Report to:
Conservation Division
State Corporation Commission
212 North Market, Insurance Bldg.
Wichita, Kansas

NORTH

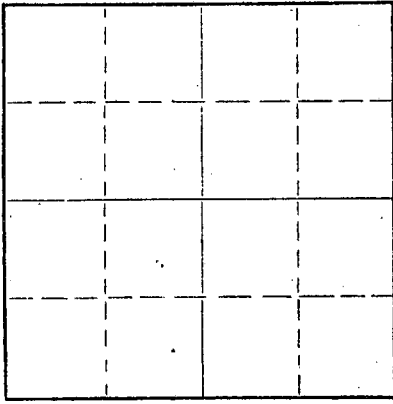

Locate well correctly on above
Section Plat

Graham County, Sec. 2 Twp. 8S Rge. 24W (E) (W)
Location as "NE/CNW/SW" or footage from lines NW NW NE
Lease Owner Leben Drilling, Inc.
Lease Name Welty Well No. 1
Office Address 905 Central Bldg., Wichita, Kansas
Character of Well (completed as Oil, Gas or Dry Hole) Dry Hole
Date well completed 11-27-59 19
Application for plugging filed 11-27-59 19
Application for plugging approved 11-27-59 19
Plugging commenced 11-27-59 19
Plugging completed 11-27-59 19
Reason for abandonment of well or producing formation Dry Hole

If a producing well is abandoned, date of last production _____ 19
Was permission obtained from the Conservation Division or its agents before plugging was commenced? Yes

Name of Conservation Agent who supervised plugging of this well A. D. Fabricius
Producing formation _____ Depth to top _____ Bottom _____ Total Depth of Well 3880 Feet
Show depth and thickness of all water, oil and gas formations.

OIL, GAS OR WATER RECORDS

CASING RECORD

FORMATION	CONTENT	FROM	TO	SIZE	PUT IN	PULLED OUT
				8 5/8"	234	

Describe in detail the manner in which the well was plugged, indicating where the mud fluid was placed and the method or methods used in introducing it into the hole. If cement or other plugs were used, state the character of same and depth placed, from _____ feet to _____ feet for each plug set.

1st plug @ 500' with 20 sx. cement.
2nd plug @ 230' with 20 sx. cement.
Top plug @ 40' with 10 sx. cement.


RECEIVED
STATE CORPORATION COMMISSION
12/4/59
DEC 4 1959
CONSERVATION DIVISION
Wichita, Kansas

(If additional description is necessary, use BACK of this sheet)
Name of Plugging Contractor Leben Drilling, Inc.
Address 905 Central Bldg., Wichita, Kansas

STATE OF KANSAS, COUNTY OF SEDGWICK, ss.
James M. Battin (employee of owner) or (owner or operator) of the above-described well, being first duly sworn on oath, says: That I have knowledge of the facts, statements, and matters herein contained and the log of the above-described well as filed and that the same are true and correct. So help me God.

(Signature) James M. Battin
905 Central Bldg., Wichita, Kansas
(Address)

SUBSCRIBED AND SWORN TO before me this 30th day of November, 19 59
My commission expires April 23, 1963
Juanita M. Green
Notary Public.

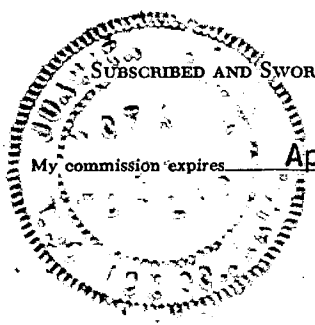

15-065-00779-00-20

DRILLER'S LOG

COMPANY:	LEHEN DRILLING, INC.
CONTRACTOR:	LEHEN DRILLING, INC.
FARM:	WELTY #1
LOCATION:	NW NW NE Sec. 2-6S-24W GRAHAM COUNTY, KANSAS
COMMENCED:	11-19-59
COMPLETED:	11-27-59

0	60	Surface Soil & Clay
60	233	Sand, Shale & Shells
233	234	Sand, Shale & Shells
234	1200	Shale
1200	1595	Shale & Shells
1595	1705	Sand
1775	1850	Shale, Shells & Red Bed
1850	2035	Shells & Red Bed
2035	2075	Anhydrite
2075	2320	Shale & Lime Streaks
2320	2485	Shale & Shells
2485	2640	Shale & Lime
2640	3020	Shale & Lime
3020	3195	Shale & Lime
3195	3310	Lime
3310	3440	Lime & Shale
3440	3520	Lime
3520	3755	Lime
3755	3880	Lime
	3880	<u>Rotary Total Depth - D & A</u>

RECEIVED
STATE CORPORATION COMMISSION

DEC 4 1959

CONSERVATION DIVISION
Wichita, Kansas

12/4/59

Set 8 5/8" surface casing @ 234' with 150 sacks Sunset cement.

I, James Mattin, do hereby certify that the above and foregoing is a true and correct copy of the log of the Welty #1, located NW NW NE of Section 2, Township 8 South, Range 24 West, Graham County, Kansas, as reflected by the files of Lehen Drilling, Inc.

James M. Mattin
James Mattin

STATE OF KANSAS)
 SS
COUNTY OF SEDGWICK)

Subscribed and sworn to before me, a Notary Public, in and for Sedgwick County, Kansas, this 1st day of December, 1959.

Juanita M. Green
Juanita M. Green, Notary Public

