


15-065-00375-00-00

WELL PLUGGING RECORD

Give All Information Completely
Make Required Affidavit
Mail or Deliver Report to:
Conservation Division
State Corporation Commission
800 Bittling Building
Wichita, Kansas

Graham County, Sec. 3 Twp. 8 Rge. 24 ~~XX~~ (W)

Location as "NE/CNW $\frac{1}{4}$ SW $\frac{1}{4}$ " or footage from lines C, SW NW SE $\frac{1}{4}$
Lease Owner E. K. Carey, Contractor
Lease Name A. Evans Well No. 1
Office Address Box 620, McPherson, Kansas
Character of Well (completed as Oil, Gas or Dry Hole) Dry Hole
Date well completed January 1, 19 53
Application for plugging filed December 31, 19 52
Application for plugging approved January 1, 19 53
Plugging commenced Noon January 1, 19 53
Plugging completed 8 A.M. January 1, 19 53
Reason for abandonment of well or producing formation Dry Hole

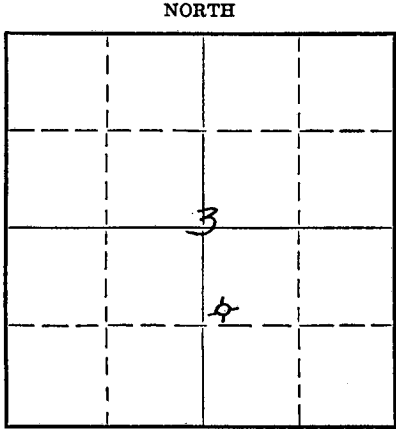

Locate well correctly on above Section Plat

If a producing well is abandoned, date of last production - None 19
Was permission obtained from the Conservation Division or its agents before plugging was commenced? Yes

Name of Conservation Agent who supervised plugging of this well Eldon Petty
Producing formation Depth to top Bottom Total Depth of Well 3812 Feet
Show depth and thickness of all water, oil and gas formations.

OIL, GAS OR WATER RECORDS

CASING RECORD

Formation	Content	From	To	Size	Put In	Pulled Out
				8-5/8	163.51	None
				Cemented at 162' w/100 sacks cement circulated		

Describe in detail the manner in which the well was plugged, indicating where the mud fluid was placed and the method or methods used in introducing it into the hole. If cement or other plugs were used, state the character of same and depth placed, from feet to feet for each plug set.

Gunned pits, circulated heavy mud on bottom and half way out. Set solid plug at 159' with 15 sacks cement on this plug. Filled hole with heavy mud to 40', set plug at 40' and 10 sacks cement to cellar floor.

(If additional description is necessary, use BACK of this sheet)

Correspondence regarding this well should be addressed to Herbert Rhoton
Address Box 620, McPherson, Kansas

STATE OF Kansas, COUNTY OF McPherson, ss.
Herbert Rhoton (employee of owner) or (owner or operator) of the above-described well, being first duly sworn on oath, says: That I have knowledge of the facts, statements, and matters herein contained and the log of the above-described well as filed and that the same are true and correct. So help me God.

(Signature) Herbert Rhoton
Box 620, McPherson, Kansas
(Address)

SUBSCRIBED AND SWORN to before me this 5th day of January, 1953

My commission expires November 13, 1956


23-5091-s 8-50-10M

RECEIVED
STATE CORPORATION COMMISSION
Notary Public.

JAN 15 1953

CONSERVATION DIVISION
Wichita, Kansas

PLUGGING
FILE SEC 378-242
BOOK PAGE 62 LINE 38

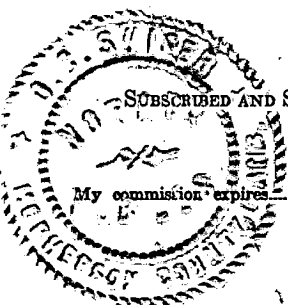

1/15/53

15-065-00375-00-00

MALLONEE DRILLING COMPANY, INC.
812 Central Bldg.
Wichita, 2, Kansas

DRILLER'S LOG
Evans #1

SW/4 SE Sec. 3, Twp. 8S, Rge. 24W
Graham County, Kansas

Commenced: 12-17-52
Completed: 12-31-52

Elev.: 2328
D & A

<u>FROM</u>	<u>TO</u>	<u>DESCRIPTION</u>	<u>REMARKS</u>
0	75	Surface soil, shale	
75	100	Shale	
100	140	Shale and shells	
140	162	Shale	163' (5 jts.) 8-5/8 Surface Casing set at 162' with 100 lbs. cement and 1 sk. C.C.
162	1500	Shale and shells	
1500	1715	Red bed	
1715	1960	Red bed and shale	
1960	1995	Anhydrite	
1995	2275	Shale and shells	
2275	2400	Lime, shells and shale	
2400	2500	Shale and shells	
2500	2660	Shale and lime shells	
2660	2695	Broken lime	
2695	2750	Shale and shells, lime	
2750	2830	Shale and shells	
2830	2915	Shale and lime streaks	
2915	2975	Shale and shells, lime streaks	
2975	3020	Lime	
3020	3060	Shale and lime streaks	
3060	3105	Lime and shale	
3105	3190	Shale and shells	
3190	3406	Lime and shale	
3406	3485	Lime	
3485	3575	Lime and shale	
3575	3312	Lime	
	3312	Total Depth of Hole	

TOPS:

Heebnor 3541
Lans.-K.C. 3574

1/15/53

I certify that to the best of my knowledge and belief the above represents a true and accurate Driller's Log record of this well.

PLUGGING

FILE SEC 3 8 24

BOOK PAGE 69 LINE 38

R. E. Mallonee