


15-015-00576-00-00

STATE OF KANSAS
STATE CORPORATION COMMISSION

Form CP-4

Give All Information Completely
Make Required Affidavit
Mail or Deliver Report to:
Conservation Division
State Corporation Commission
212 No. Market
Wichita, Kansas 67202

WELL PLUGGING RECORD

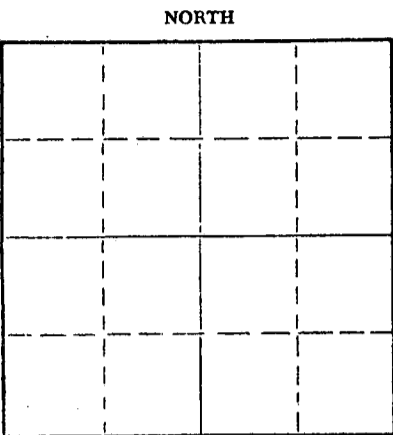

Locate well correctly on above
Section Plat

Butler County. Sec. 24 Twp. 28 Rge. 3 (E) (W)
Location as "NE/CNW/SW" or footage from lines SE SE NE
Lease Owner Geo. Scoonmaker
Lease Name Rowland Well No. 1
Office Address Old Nat'l Bank Bldg., Evansville, Indiana
Character of Well (completed as Oil, Gas or Dry Hole) D&A
Date well completed 12-31-59 19____
Application for plugging filed 1-7-60 19____
Application for plugging approved 1-7-60 19____
Plugging commenced 12-31-59 19____
Plugging completed 12-31-59 19____
Reason for abandonment of well or producing formation _____

If a producing well is abandoned, date of last production _____ 19____
Was permission obtained from the Conservation Division or its agents before plugging was commenced? Yes

Name of Conservation Agent who supervised plugging of this well Lee N. Guthrie
Producing formation _____ Depth to top _____ Bottom _____ Total Depth of Well 2950 Feet
Show depth and thickness of all water, oil and gas formations.

OIL, GAS OR WATER RECORDS

CASING RECORD

FORMATION	CONTENT	FROM	TO	SIZE	PUT IN	PULLED OUT

Describe in detail the manner in which the well was plugged, indicating where the mud fluid was placed and the method or methods used in introducing it into the hole. If cement or other plugs were used, state the character of same and depth placed, from _____ feet to _____ feet for each plug set.

130' 8 5/8" surface pipe set. Cement circulated, mud hole to 200'. Set plug 1/4 sack hulls. 25 sacks cement, mud to 35', set plug, 1/4 sack hulls. 10 sacks cement which filled hole to surface. Put 2 sacks cement in rat hole.

*Received
11/7/60*

(If additional description is necessary, use BACK of this sheet)
Name of Plugging Contractor Glenn-Drilling Company
Address Petroleum Building, El Dorado, Kansas

STATE OF Kansas, COUNTY OF Sedgwick, ss.

(employee of owner) or (owner or operator) of the above-described well, being first duly sworn on oath, says: That I have knowledge of the facts, statements, and matters herein contained and the log of the above-described well as filed and that the same are true and correct. So help me God.

(Signature) Acting Agent Bill Draper

(Address)

SUBSCRIBED AND SWORN TO before me this _____ day of _____, 19____

My commission expires _____

Notary Public.