


STATE OF KANSAS
STATE CORPORATION COMMISSION

Give All Information Completely
Make Required Affidavit
Mail or Deliver Report to:
Conservation Division
State Corporation Commission
800 Biting Building
Wichita, Kansas

OR
FORMATION PLUGGING RECORD

Strike out upper line
when reporting plug-
ging off formations.

Butler County. Sec. 24 Twp. 28 Rge. 3 (E) E (W)
Location as "NE 1/4 NW 1/4 SW 1/4" or footage from lines. SW SW NW
Lease Owner. D. M. Shawver et al
Lease Name. Kirkpatrick Well No. #1
Office Address. 204 N. Market, Wichita, Kansas
Character of Well (completed as Oil, Gas or Dry Hole) Dry
Date well completed. October 13, 1947
Application for plugging filed. attached 19
Application for plugging approved. November 25, 1947
Plugging commenced. November 25, 1947
Plugging completed. November 27, 1947
Reason for abandonment of well or producing formation Dry

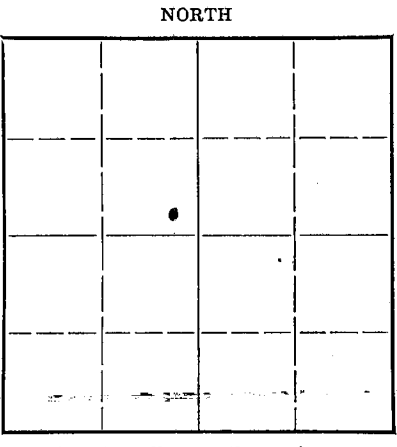

Locate well correctly on above
Section Plat

If a producing well is abandoned, date of last production. 19
Was permission obtained from the Conservation Division or its agents before plugging was com-
menced? Yes

Name of Conservation Agent who supervised plugging of this well. A. L. Loman
Producing formation. Depth to top. Bottom. Total Depth of Well. 2975 Feet
Show depth and thickness of all water, oil and gas formations.


OIL, GAS OR WATER RECORDS

CASING RECORD

Formation	Content	From	To	Size	Put In	Pulled Out

Describe in detail the manner in which the well was plugged, indicating where the mud fluid was placed and the method or methods used in introducing it into the hold. If cement or other plugs were used, state the character of same and depth placed, from feet to feet for each plug set.
Mud: 2975' - 2952'
3 Sacks Cement at 2952'
Mud to 135'
10' Rock Bridge - 15 Sacks Cement at 135'
Mud to Top
5 Sacks Cement Cap

(Well Log Attached)

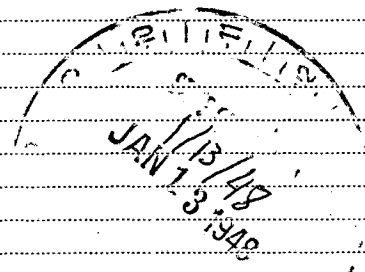

(If additional description is necessary, use BACK of this sheet)

Correspondence regarding this well should be addressed to. Shawver-Graham, Inc.
Address. 204 North Market
Wichita 2, Kansas

STATE OF KANSAS, COUNTY OF Sedgewick, ss.
President (employee of owner) or (owner or operator) of the above-described well,


being first duly sworn on oath, says: That I have knowledge of the facts, statements, and matters herein contained and the log of the above-described well as filed and that the same are true and correct. So help me God.

(Signature) *D. M. Shawver*


(Address)

SUBSCRIBED AND SWORN to before me this 27th day of December, 1947.

Henry S. Fischer
Notary Public.

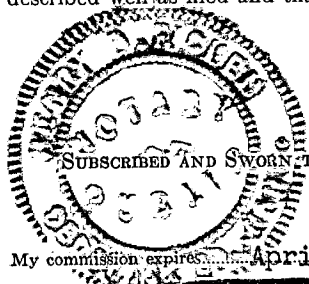

My commission expires April 18, 1951.

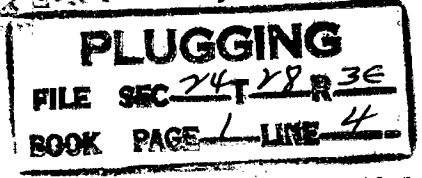

KIRKPATRICK WELL NO. 1

Location: S $\frac{1}{2}$ NW $\frac{1}{4}$ & SW $\frac{1}{4}$ NW $\frac{1}{4}$
24-28-3E
Butler County, Kansas

Commenced: 9-27-47

Completed: 10-19-47

Operator: Shawver-Graham, Inc.

Casing Record: 135' 8 5/8" Surface Pipe
Cemented with 90 sacks cement
2952' 5 $\frac{1}{2}$ " Casing

LOG

(Figures indicate bottom of formation)

Clay	37	Shale & Lime	2375
Shale & Shells	48	Lime	2420
Sand & Gravel	57	Shale & Lime	2455
Shale	65	Shale	2485
Red Rock	99	Lime & Shale	2560
Lime	180	Shale & Shells	2665
Sand	215	Lime	2800
Shale & Shells	460	Shale & Lime	2828
Lime & Shale	645	Lime	2865
Shale & Shells	970	Shale	2870
Shale & Lime	1585	Lime & Shale	2957
Shale & Shells	1725	Shale	2962
Shale & Lime	1840	Sand hard	2964
Lime	1975	Sand soft	2966
Lime & Shale	1990	Saturated Clusters	2966
Lime	2190	Sand (no showing)	2973
Shale	2255	Churty lime	2979
Lime	2285	Hole full water	2979

The undersigned, Shawver-Graham, Inc., hereby certifies that the above log is a true and correct log of the formations encountered in drilling the above noted well as reflected by the Daily Drilling Reports.

SHAWVER-GRAHAM, INC.

By: (signed)
President

STATE OF KANSAS)
(SS
COUNTY OF SEDGWICK)

Be it remembered that on this ____ day of October, 1947, before me the undersigned, a notary public, duly commissioned in and for the County and State aforesaid, came D. M. SHAWVER, President of SHAWVER-GRAHAM, INC., a corporation of the State of Kansas, personally known to me to be such officer, and to be the same person who executed as such officer the foregoing instrument of writing in behalf of said corporation, and he duly acknowledged the execution of the same for himself and for said corporation.

IN WITNESS WHEREOF, I have hereunto set my hand and official seal on the day and year last above written.

(signed)
Notary Public

My commission expires April 18, 1951.

PLUGGING
FILE SEC 24278 R 36
BOOK 1 4

C O P Y