


15-015-19872-00-00

WELL PLUGGING RECORD

NORTH

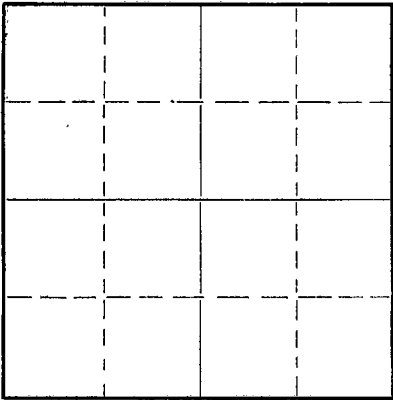

Locate well correctly on above
Section Plat

Butler County, Sec. 26 Twp. 28 Rge. 3 (E) 2025
Location as "NE/CNW $\frac{1}{4}$ SW $\frac{1}{4}$ " or footage from lines SE NW NW
Lease Owner W. G. Talbott et al.
Lease Name Hawks Well No. 8
Office Address 708 Petroleum Bldg.
Character of Well (completed as Oil, Gas or Dry Hole) Oil Well
Date well completed October 15, 19 48
Application for plugging filed 2/23 19 51
Application for plugging approved 2/23 19 51
Plugging commenced 2/27 19 51
Plugging completed 3/3 19 51
Reason for abandonment of well or producing formation Making to much water.
If a producing well is abandoned, date of last production February 15, 19 51
Was permission obtained from the Conservation Division or its agents before plugging was commenced? Yes
Name of Conservation Agent who supervised plugging of this well A. L. Loman
Producing formation Simpson Depth to top. 2984 Bottom Total Depth of Well 3,000 Feet
Show depth and thickness of all water, oil and gas formations.

OIL, GAS OR WATER RECORDS

CASING RECORD

Formation	Content	From	To	Size	Put In	Pulled Out
		Surface	167	8 5/8	167	None
			2965	5 1/2	2965	2750

Describe in detail the manner in which the well was plugged, indicating where the mud fluid was placed and the method or methods used in introducing it into the hole. If cement or other plugs were used, state the character of same and depth placed, from feet to feet for each plug set.

Dumped 5 sx of cement on Bottom and mud to 180' - 15 sx cement on 10' rock Bridge @ 165' - mud to surface - 5 sx cement cap.

(If additional description is necessary, use BACK of this sheet)

Correspondence regarding this well should be addressed to W. G. Talbott
Address 708 Petroleum Bldg. Wichita, Kansas

STATE OF Kansas, COUNTY OF Sedgwick, ss.
W. G. Talbott (employee of owner or operator) of the above-described well,
being first duly sworn on oath, says: That I have knowledge of the facts, statements, and matters herein contained and the log of the above-described well as filed and that the same are true and correct. So help me God.


(Signature) W. G. Talbott

708 Petroleum Bldg.
(Address)

SUBSCRIBED AND SWORN to before me this 12 day of March, 1951

My commission expires October 13, 1952

22-5138-s 9-48-10M

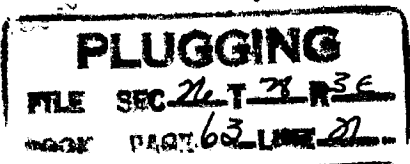

RECEIVED
STATE CORPORATION COMMISSION
3/13/51
MAR 13 1951
CONSERVATION DIVISION
Wichita, Kansas

Notary Public.

15-015-19872-00-00

Company: Talbott & Sohio
Farm: Hawks #8

Comm: October 7, 1943
Comp: October 15, 1948

Contractor: Penguin Petroleum, Inc.

Casing: 8 5/8" @ 167'
5" @ 2965'

Section 26, T 28 S, R 3 E
SE NW NW
Butler County, Kansas
Rotary Tools
Elevation: 1323'
Total Depth: 3000'
Initial Potential:

0-72	
-120	clay
-145	sand
-160	shale
-165	lime
-210	shale and lime
-320	lime and shale
-330	red bed
-360	lime and shale
-367	gray shale
-380	shale
-390	lime shells
-1145	lime and shale
-1760	shale and shells
-2005	shale and lime
-2235	lime and shale
-2300	shale and shells
-2685	lime
-2760	lime and shale
-2850	lime
-2905	lime broken
-2965	shale and lime
-2984	shale
-3000	sand


R.U.S.T. 2965'

Total Depth 3000'

Free show of oil 2985-89'


Tops: Simpson 2934'

Certified to be a true copy of the well log as indicated on daily drilling reports.

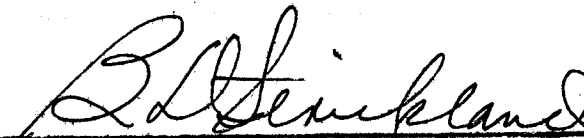
Penguin Petroleum, Inc.

Subscribed and sworn to before me, the undersigned, a Notary Public in and for Sedgwick County, Kansas, ~~by~~ _____, this 22 day of February, 1951.

My Commission expires _____
My commission expires Oct. 27, 1954

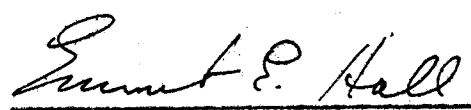
Notary Public

