


STATE OF KANSAS
STATE CORPORATION COMMISSION

Give All Information Completely
Make Required Affidavit
Mail or Deliver Report to:
Conservation Division
State Corporation Commission
212 No. Market
Wichita, Kansas 67202

WELL PLUGGING RECORD

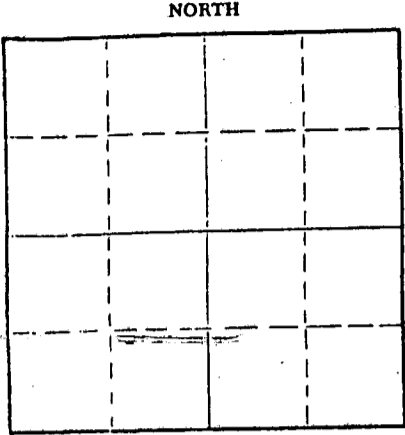

Locate well correctly on above
Section Plat

Butler County, Sec. 26 Twp. 28 Rge. 3E (E) (W)
Location as "NE/CNWxSWx" or footage from lines 660' S nl & 280' E w1 NE NW4
Lease Owner U.S. Minerals & Royalty Co.
Lease Name Richards Well No. 1
Office Address 2902 Fort Worth National Bank Bldg. Fort Worth, Texas
Character of Well (completed as Oil, Gas or Dry Hole) Dry
Date well completed 5-12-76 19__
Application for plugging filed 5-12-76 19__
Application for plugging approved 5-12-76 19__
Plugging commenced 5-12-76 19__
Plugging completed 5-12-76 19__
Reason for abandonment of well or producing formation _____

If a producing well is abandoned, date of last production _____ 19__
Was permission obtained from the Conservation Division or its agents before plugging was commenced? yes

Name of Conservation Agent who supervised plugging of this well Ted Dewey
Producing formation _____ Depth to top _____ Bottom _____ Total Depth of Well 2994 Feet
Show depth and thickness of all water, oil and gas formations.

OIL, GAS OR WATER RECORDS

CASING RECORD

FORMATION	CONTENT	FROM	TO	SIZE	PUT IN	PULLED OUT

Describe in detail the manner in which the well was plugged, indicating where the mud fluid was placed and the method or methods used in introducing it into the hole. If cement or other plugs were used, state the character of same and depth placed, from _____ feet to _____ feet for each plug set.

Fluid to 240' 20 sks cement
Fluid to 40' 10 sks cement
2 sks in rat hole

RECEIVED
STATE CORPORATION COMMISSION
6/14/76
JUN 14 1976

CONSERVATION DIVISION
Wichita, Kansas

(If additional description is necessary, use BACK of this sheet)
Name of Plugging Contractor Triangle Drilling Co.
Address 324 N. Orchard, El Dorado, Kansas 67042

STATE OF Kansas, COUNTY OF Butler, ss.
Harry Hughes (employee of owner) or (owner or operator) of the above-described well, being first duly sworn on oath, says: That I have knowledge of the facts, statements, and matters herein contained and the log of the above-described well as filed and that the same are true and correct. So help me God.

(Signature) Harry Hughes

(Address)

Subscribed and sworn to before me this 27 day of May, 1976

Juanita Hughes
Notary Public.

My commission expires Nov. 11 1976

JUN 4 REC'D

Operator U. S. Minerals & Royalty Co.
 Comm _____ Comp _____
 Shot _____ Qts. From _____ ft. To _____ ft.
 Acidized _____ Gal. _____
 Prod. Formation _____
 Initial Prod. _____
 Elevation _____

Lease Richards Well No. 1
 Loc 660; E 1/4 Sec 26 Twp 28 Rge 3E
 County Butler State Kansas
 Contractor Triangle Drilling Co.
 Casing Record

Size	Wt.	Pulled	Remarks
8 5/8	215	145 Sks	Cement

15-015-20808-00-00

FIGURES INDICATE BOTTOM OF FORMATION

0	215	Surface
215	630	Lime and Shale
630	920	Lime and Shale
920	1245	Shale and Lime
1245	1340	Shale and Lime
1340	1520	Lime and Shale
1520	1612	Lime
1612	2460	Lime and Shale
2460	2620	Shale & Lime
2620	2690	Lime
2690	2725	Lime & Shale
2725	2805	Lime
2805	2937	Lime & Shale
2937	2990	Kn Shale
2990	2994	Sand RTD

10' 10 sks cement
 2 sks in rat hole

RECEIVED
 STATE CORPORATION COMMISSION

JUN 14 1976

CONSERVATION DIVISION
 Wichita, Kansas