


WELL PLUGGING RECORD

Give All Information Completely
Make Required Affidavit
Mail or Deliver Report to:
Conservation Division
State Corporation Commission
800 Bitting Building
Wichita, Kansas

NORTH

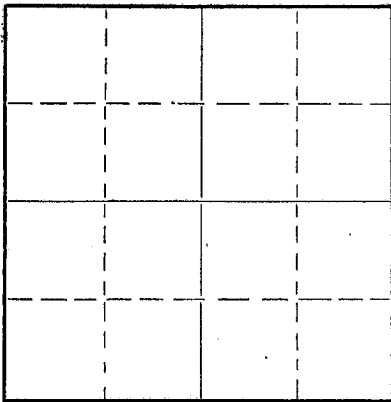

Locate well correctly on above
Section Plat

Butler County. Sec. 27 Twp. 28 Rge. 3 (E) (27)
Location as "NE/CNW 1/4 SW 1/4" or footage from lines NE NE SE
Lease Owner W. G. Talbott, et-al.
Lease Name Hawks "B" Well No. 1
Office Address 708 Petroleum Bldg.
Character of Well (completed as Oil, Gas or Dry Hole) Oil Well
Date well completed 12/28 19.48
Application for plugging filed 2/23 19.51
Application for plugging approved 2/23 19.51
Plugging commenced 2/23 19.51
Plugging completed 2/27 19.51
Reason for abandonment of well or producing formation Depleted
If a producing well is abandoned, date of last production 2-15 19.51
Was permission obtained from the Conservation Division or its agents before plugging was commenced? Yes

Name of Conservation Agent who supervised plugging of this well A. L. Loman
Producing formation Simpson Depth to top 2974 Bottom Total Depth of Well 2982 Feet
Show depth and thickness of all water, oil and gas formations.

OIL, GAS OR WATER RECORDS

CASING RECORD

Formation	Content	From	To	Size	Put In	Pulled Out
				8 5/8	154	None
				5 1/2	2962	2750

Describe in detail the manner in which the well was plugged, indicating where the mud fluid was placed and the method or methods used in introducing it into the hole. If cement or other plugs were used, state the character of same and depth placed, from feet to feet for each plug set.

5 sx cement on bottom - mud to 165' - 15 sx cement on top of
15' rock bridge @ 150' - mud to surface 5 sx cement cap.

(If additional description is necessary, use BACK of this sheet)

Correspondence regarding this well should be addressed to W. G. Talbott
Address 708 Petroleum Bldg. Wichita, Kansas

STATE OF Kansas, COUNTY OF Sedgwick, ss.
W. G. Talbott (operator) of the above-described well,
being first duly sworn on oath, says: That I have knowledge of the facts, statements, and matters herein contained and the log of the above-described well as filed and that the same are true and correct. So help me God.

(Signature) W. G. Talbott

708 Petroleum Building (Address)

SUBSCRIBED AND SWORN TO before me this 12 day of March, 19.51

Notary Public

My commission expires October 13, 1952

PLUGGING
FILE SEC 27 T 28 R 36
BOOK PAGE 63 LINE 22

MAR 13 1951
CONSERVATION DIVISION
Wichita, Kansas

15-015-19887-00-00

Company: Talbott & Sohio
Farm: Hawks B-#1
Comm: December 13, 1948
Comp: December 28, 1948
Contractor: Penguin Petroleum, Inc.

Section 27, T 28 S, R 3 E
NE NE SE
Butler County, Kansas
Rotary Tools
Elevation: 1306' R.B.
Total Depth: 2982'
Initial Potential: 50 bbls.

Casing: 8" @ 154'
5 1/2" @ 2962'

0-6	Soil clay
-15	Shale
-35	Shale and lime
-60	Shale
-70	Lime
-75	Shale
-85	Lime
-95	Shale, blue
-120	Red shale
-130	Shale
-154	Lime
-330	Lime broken
-340	Lime sharp
-405	Lime broken
-700	Shale and lime
-1000	Shale
-1028	Sand
-1340	Shale and shells
-2288	Lime and shale
-2680	Lime
-2752	Shale
-2854	Lime
-2919	Shale and lime
-2962	Shale
-2974	Dark shale
-2982	Sand

R.U.S.T. 2962'

2982' - Total Depth from Rotary Bushing

Tops: Kansas City limestone	@ 2290'
Mississippian limestone	2752'
Kinderhook	2897'
Simpson sandstone	2974'

Water Record:	1 BWPH	45'
	2 BWPH	55'
	HFW	120-130'

First show	2975-2978'
Free oil	2978-2982'

RECEIVED
STATE CORPORATION COMMISSION
FEB 23 1951
CONSERVATION DIVISION
Wichita, Kansas

Certified to be a true copy of the well log as indicated on daily drilling reports.

Penguin Petroleum, Inc.

by

Jack Brown

Subscribed and sworn to before me, the undersigned, a Notary Public in and for Sedgwick County, Kansas, this 5th day of January, 1949.

My Commission Expires:

October 13, 1952

B. D. Strickland
Notary Public

PLUGGING
FILE SEC 27 T 28 S R 3 E
BOOK PAGE 63 LINE 22