


Give All Information Completely
Make Required Affidavit
Mail or Deliver Report to:
Conservation Division
State Corporation Commission
212 North Market, Insurance Bldg.
Wichita, Kansas

WELL PLUGGING RECORD

NORTH

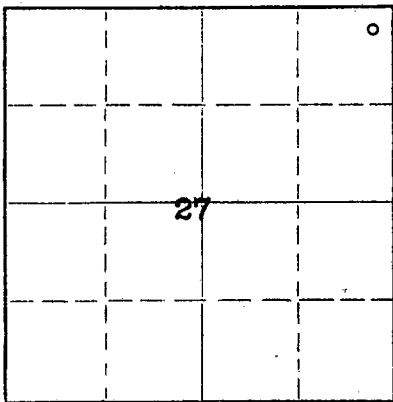

Locate well correctly on above
Section Plat

Butler County. Sec 27 Twp. 28 Rge. 3 (E) ~~xxx~~
Location as "NE/CNW/SW" or footage from lines NE NE NE
Lease Owner W. G. Talbott, et al
Lease Name Hawks Well No. 2
Office Address 309 Insurance Bldg., Wichita, Kansas
Character of Well (completed as Oil, Gas or Dry Hole) Oil
Date well completed March 22, 19 47
Application for plugging filed January 28, 19 59
Application for plugging approved January 30, 19 59
Plugging commenced February 22, 19 59
Plugging completed February 27, 19 59
Reason for abandonment of well or producing formation
Ceased producing commercially
If a producing well is abandoned, date of last production February 20, 19 59
Was permission obtained from the Conservation Division or its agents before plugging was commenced? Yes

Name of Conservation Agent who supervised plugging of this well Eugene H. Graham
Producing formation Simpson Depth to top 2982 Bottom 2987 Total Depth of Well 2987 Feet
Show depth and thickness of all water, oil and gas formations.

OIL, GAS OR WATER RECORDS

CASING RECORD

FORMATION	CONTENT	FROM	TO	SIZE	PUT IN	PULLED OUT
Drilled with Rotary Tools				8-5/8"	143'	None
				5 1/2"	2973'	1555'

Describe in detail the manner in which the well was plugged, indicating where the mud fluid was placed and the method or methods used in introducing it into the hole. If cement or other plugs were used, state the character of same and depth placed, from _____ feet to _____ feet for each plug set.

Dumped 6 sx. cement on bottom, 2987
Mudded hole to 180' of surface
Set 15' rock bridge
Dumped 10 sx. cement on bridge
Mudded to 40'
Set 15' rock bridge
Filled to surface with cement

Received
4/27/61

(If additional description is necessary, use BACK of this sheet)
Name of Plugging Contractor Butler County Drilling Company
Address Orpheum Building, Wichita, Kansas


STATE OF KANSAS, COUNTY OF SEDGWICK, ss.
W. G. TALBOTT (owner or operator) of the above-described well, being first duly sworn on oath, says: That I have knowledge of the facts, statements, and matters herein contained and the log of the above-described well as filed and that the same are true and correct. So help me God.

(Signature) W. G. Talbott
309 Insurance Bldg., Wichita, Kans.
(Address)

SUBSCRIBED AND SWORN to before me this 13th day of March, 19 59

Neil M. Leonard

Notary Public.

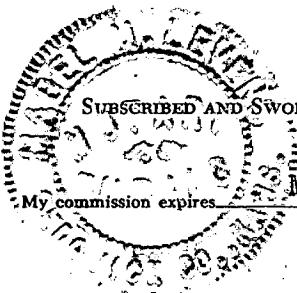

PLUGGING			
FILE	SEC	T	R
	27	29	3E
BOOK	PAGE	LINE	
	14	3	

15-015-19884-00-00

c
o
p
yc
o
p
yCONTRACTOR'S VERIFIED LOG

Operator: Pabco & Sohio
 Farm Name: Hawks
 Well No. 2
 Location: NE NE NE Section 27, Township 28, Range 3E
 Butler County, Kansas
 Commenced: March 22, 1947
 Completed: April 9, 1947

CASING: 5" 2973'
 8" 143'

From	Depth	To	
0	6		soil and clay
	18		lime shells and clay
	45		blue shale
	65		shale
	85		lime
	100		shale
	110		red rock
	125		lime and shale
	135		lime
	143		lime
	330		lime and shale
	590		lime
	905		shale and shells
	1115		shale and lime
	1325		shale and lime shells
	1475		shale and shells
	1675		shale and lime
	1910		shale
	2110		shale and lime
	2350		lime and shale
	2480		lime
	2755		lime and shale
	2855		lime
	2920		lime and shale
	2973		shale (Rotary Total Depth)
	2982		black shale
	2987		sand
			Total Depth (cable tool) - 2987

JAN 30 1959
 CONSERVATION DIVISION
 Wichita, Kansas

Slope test-
 727 ($\frac{1}{2}$ off)

Slope test-
 1606 (OK)
 Slope test-
 2125 (less
 than 1° off)
 Slope test-
 2632 (less
 than 1° off)

The foregoing Well Log and other data are correct.

Deviation from vertical Data is correct
 as shown.

PABCO DRILLING, INC.
 Contractor

Signed: (Signed) W. G. TALBOTT

by (Signed) W. G. TALBOTT

PLUGGING
 FILE SEC. 27 T 28 R 3E
 BOOK PAGE 14 LINE 3