


Give All Information Completely
Make Required Affidavit
Mail or Deliver Report to:
Conservation Division
State Corporation Commission
211 No. Broadway
Wichita, Kansas

WELL PLUGGING RECORD

15-015-19883-00-00

NORTH

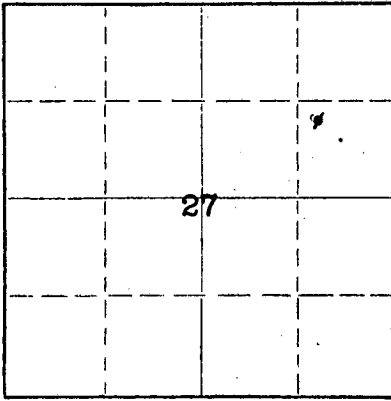

Locate well correctly on above Section Plat

Butler County. Sec. 27 Twp. 28 Rge. 3 (E) ~~XXXX~~

Location as "NE/CNW&SW&" or footage from lines NW SE NE

Lease Owner W.G. Talbott, et al (ABC KCC)

Lease Name Hawks Well No. 15

Office Address 309 Insurance Bldg., Wichita 2, Kansas

Character of Well (completed as Oil, Gas or Dry Hole) Oil

Date well completed March 1, 19 49

Application for plugging filed August 15, 19 58

Application for plugging approved August 18, 19 58

Plugging commenced August 21, 19 58

Plugging completed August 23, 19 58

Reason for abandonment of well or producing formation

Ceased producing commercially

If a producing well is abandoned, date of last production June 30, 19 58

Was permission obtained from the Conservation Division or its agents before plugging was commenced? Yes

Name of Conservation Agent who supervised plugging of this well Eugene H. Graham, Winfield, Kansas

Producing formation Simpson Depth to top 2968 Bottom 2976 Total Depth of Well 2976 Feet

Show depth and thickness of all water, oil and gas formations.

OIL, GAS OR WATER RECORDS

CASING RECORD

FORMATION	CONTENT	FROM	TO	SIZE	PUT IN	PULLED OUT
<u>Drilled with Rotary</u>	<u>Tools</u>			<u>8-5/8"</u>	<u>162'</u>	<u>None</u>
				<u>5-1/2"</u>	<u>2952'</u>	<u>2720</u>

Describe in detail the manner in which the well was plugged, indicating where the mud fluid was placed and the method or methods used in introducing it into the hole. If cement or other plugs were used, state the character of same and depth placed, from _____ feet to _____ feet for each plug set.

Dumped 5 sacks cement on bottom -- 2976'

Mudded hole to 200' of surface

Set 15' rock bridge at 195'

Dumped 15 sacks cement on bridge

Set 10' rock bridge at 30'

Filled to surface with cement

RECEIVED
STATE CORPORATION COMMISSION
9/10/58
SEP 10 1958

CONSERVATION DIVISION
Wichita, Kansas

(If additional description is necessary, use BACK of this sheet)

Name of Plugging Contractor Butler County Drilling Co.

Address Orpheum Building, Wichita, Kansas

STATE OF KANSAS COUNTY OF SEDGWICK, ss.

W. G. Talbott (owner or operator) of the above-described

well, being first duly sworn on oath, says: That I have knowledge of the facts, statements, and matters herein contained and the log of the above-described well as filed and that the same are true and correct. So help me God.

(Signature) W. G. Talbott


309 Insurance Bldg., Wichita, Kans.

(Address)

SUBSCRIBED AND SWORN TO before me this 10th day of September, 19 58

Mabel M. Levens
Mabel M. Levens Notary Public.

My commission expires May 25, 1961

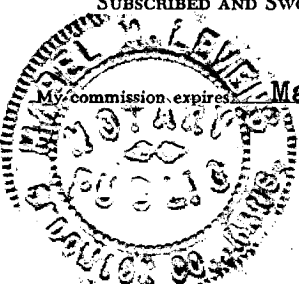

PLUGGING
FILE SEC 27 T. 28 R. 3 E.
BOOK PAGE 123 LINE 14

C o p y

C o p y

Company: Talbott & Sohio
 Farm: Hawks #15
 Comm: February 9, 1949
 Comp: March 1, 1949
 Contractor: Penguin Petroleum, Inc.

Section 27, T 28S, R 3E
 NW SE NE
 Butler County, Kansas
 Rotary Tools
 Elevation: 1303' R.B.
 Total Depth: 2976'

Casing: 8-5/8" @ 162'
 5-1/2" @ 2952'

0-148 Lime and shale
 -151 Sand
 -175 Lime
 -338 Lime broken
 -348 Sand hard
 -350 Lime
 -690 Lime and shale
 -1015 Shale and shells
 -1375 Shale
 -1585 Shale and lime
 -1690 Lime and shale
 -2015 Shale
 -2067 Lime
 -2080 Shale
 -2240 Lime and shale
 -2300 Shale
 -2530 Lime
 -2675 Lime and shale
 -2766 Shale and lime
 -2893 Lime
 -2952 Shale

R.T.D. 2952'

-2968 Shale
 -2973.5 Sand
 -2976 Sand stained

Total Depth 2976'

Cored 2969-76'

Tops: Kansas City limestone @ 2290'
 Mississippian limestone @ 2750'
 Kinderhook @ 2893'
 Simpson sandstone @ 2969'

Certified to be a true copy of the well log as indicated on daily drilling reports.

Penguin Petroleum, Inc.

(NOTARY SEAL)

By: (Signed) JACK BROWN

Subscribed and sworn to before me, the undersigned, a Notary Public in and for Sedgwick County, Kansas, this 8th day of March, 1949.

My Commission Expires:

October 13, 1952

(Signed) B. D. STRICKLAND

PLUGGING			
FILE	SEC 27	T 28	R 3E
BOOK	PAGE 123 LINE 14		