


STATE OF KANSAS
STATE CORPORATION COMMISSION

Give All Information Completely
Make Required Affidavit
Mail or Deliver Report to:
Conservation Division
State Corporation Commission
800 Bittling Building
Wichita, Kansas

15-015-00012-00-00

WELL PLUGGING RECORD

NORTH

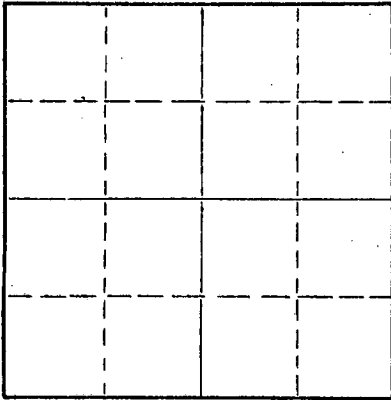

Locate well correctly on above
Section Plat

Butler County, Sec. 36 Twp. 28s. Rge. 3e. (E) (W)
Location as "NE/CNW/SW" or footage from lines
Lease Owner Drolte- Kuper Oil
Lease Name J.C. Bates Well No. 1
Office Address 2022 Fannin Amarillo, Texas
Character of Well (completed as Oil, Gas or Dry Hole) Dry Hole
Date well completed Sept, 13 1955
Application for plugging filed 19____
Application for plugging approved 19____
Plugging commenced Sept 13 1955
Plugging completed Sept, 13 1955
Reason for abandonment of well or producing formation _____

If a producing well is abandoned, date of last production 19____
Was permission obtained from the Conservation Division or its agents before plugging was commenced? Yes

Name of Conservation Agent who supervised plugging of this well Agent At Eldorado, Kansas
Producing formation _____ Depth to top _____ Bottom _____ Total Depth of Well 3013 Feet
Show depth and thickness of all water, oil and gas formations.

OIL, GAS OR WATER RECORDS

CASING RECORD

FORMATION	CONTENT	FROM	TO	SIZE	PUT IN	PULLED OUT
	surface	top	153	8 5/8	153	none
Lime-Rock		153	333			
Lime & Shale		333	847			
Lime & Shale		847	1369			
Lime		1369	1449			
Lime & Shale		1449	1826			
Lime		1826	2031			
Lime & Shale		2031	3013			

Describe in detail the manner in which the well was plugged, indicating where the mud fluid was placed and the method or methods used in introducing it into the hole. If cement or other plugs were used, state the character of same and depth placed, from _____ feet to _____ feet for each plug set.

Mud to 190 ft. set 10 sks on wood plug Mud to surface Set 5skscx cement
Mud to 10ft. of top Set cement cap to top

RECEIVED

STATE CORPORATION COMMISSION
11/29/55
NOV 27 1955

CONSERVATION DIVISION

Wichita, Kansas

(If additional description is necessary, use BACK of this sheet)

Name of Plugging Contractor Green & McClellan Drilling Co.
Address Rt. 2 Box 29 Pampa, Texas

STATE OF Kansas COUNTY OF Morris, ss.
Frederic P. Drolte

(Signature) Frederic P. Drolte (Address) _____
well, being first duly sworn on oath, says: That I have knowledge of the facts, statements, and matters herein contained and the log of the above-described well as filed and that the same are true and correct. So help me God.

SUBSCRIBED AND SWORN TO before me this 28th day of November, 1955

My commission expires March 28 1958.

Van A. Scholes
Van A. Scholes Notary Public.

