0 0


KANSAS CORPORATION COMMISSION OIL & GAS CONSERVATION DIVISION

WELL PLUGGING APPLICATION

Please TYPE Form and File ONE Copy

Form CP-1 September 2003 This Form must be Typed Form must be Signed All blanks must be Filled

PI # 15 - 035-21018 -00-00	(Identifier Number of this we	II). This must be listed for wells drilled since 1967; if no a	API # was issued,
ndicate original spud or completion date 8/6/76	·		
Mall Constant PETROLEUM PROPERTY SERVICES INC.		KCC License #: 31142	
vell Operator(O) oddress: _125 N. MARKET, SUITE 125	wner / Company Name) 1	City: WICHITA (Operator	's)
tate: Kansas	Zip Code: 67202	Contact Phone: (316) 265 - 3351	
	Well #:_7	Sec. 16 Twp. 33 S. R. 6	✓ East West
APX - NE - NE - NE	Spot Location / QQQQ Co	unty: COWLEY	
Feet (in exact footage) From	North / South (from ne	parest outside section corner) Line of Section (Not Lease Lin	ie)
220		parest outside section corner) Line of Section (Not Lease Lin	
heck One: 🔽 Oil Well 🔲 Gas Well	D&A Cathodic	Water Supply Well	
SWD Docket #	ENHR Docket #	Other:	·
onductor Casing Size:	Set at:	Cemented with:	Sacks
urface Casing Size: 8-5/8"	Set at: _160	Cemented with: 75	Sacks
roduction Casing Size: 4-1/2"	Set at: 3191	Cemented with: 100	Sacks
st (ALL) Perforations and Bridgeplug Sets: 314	0-46'		
ondition of Well: Good Poor		(Stone Corral Formation) Junk in Hole	





ondition of Well: Good Poor roposed Method of Plugging (attach a separate page Well Log attached to this application as required? not explain why? Sugging of this Well will be done in accordance at Name of Company Representative authorized address: P O BOX 551 Sugging Contractor: MID-KANSAS WELL Sugging Contractor: MID-KANSAS WELL Sugging Contractor: P O BOX 326, RUSSELL KS 67	Casing Leak Pe if additional space is needed): PE Pe Yes No Is ACO-1 fi with K.S.A. 55-101 et. seq. and to be in charge of plugging operations. BERVICE Company Name) 7665	(Stone Corral Formation) Junk in Hole ER KCC INSTRUCTIONS FRANSAS CO KANSAS CO MA CONS The Rules and Regulations of the State Corporation Constions: LEON KUHN Phone: (785) 483 - 1559 City / State: RUSSELL, KS 67665 KCC License #: 33695 Phone: (785) 483 - 4400	RPORATION COMMIS R 2 8 2008 ERVATION DIVISION WICHITA, KS
ondition of Well: Good Poor roposed Method of Plugging (attach a separate page) Well Log attached to this application as required? not explain why? Jugging of this Well will be done in accordance at Name of Company Representative authorized address: P O BOX 551	Casing Leak Per if additional space is needed): PE Per Yes No Is ACO-1 first No Is	(Stone Corral Formation) Junk in Hole ER KCC INSTRUCTIONS FRANSAS CO Ided? Yes No CONS The Rules and Regulations of the State Corporation Constions: LEON KUHN Phone: (785) 483 - 1559 City / State: RUSSELL, KS 67665 KCC License #: 33695 Phone: (785) 483 - 4400 ILABLE	RPORATION COMMIS AR 2 8 2008 ERVATION DIVISION WICHITA, KS

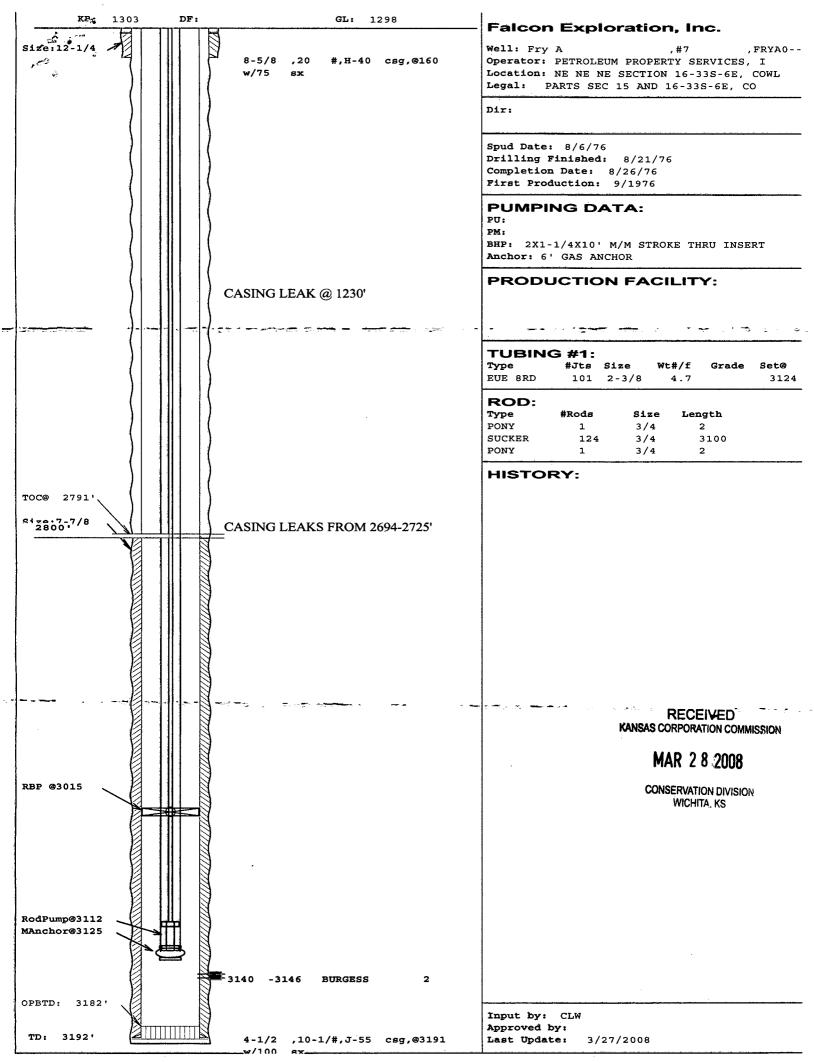



Kathleen Sebelius, Governor Thomas E. Wright, Chairman Michael C. Moffet, Commissioner Joseph F. Harkins, Commissioner

NOTICE OF RECEIPT OF WELL PLUGGING APPLICATION (CP-1)

PETROLEUM PROPERTY SERVICES, INC. 125 N MARKET SUITE 1251 WICHITA, KS 67202-1719

April 30, 2008

Re: FRY #7-A

API 15-035-21018-00-00 16-33S-6E, 330 FNL 330 FEL COWLEY COUNTY, KANSAS

Dear Operator:

This letter is to notify you that the Conservation Division has received your plugging proposal, form CP-1, for the above well and has reviewed the proposal for completeness. The central office will now forward your CP-1 to the district office listed below for review of the proposed plugging method. Please contact the district office for approval of your proposed plugging method at least five (5) days before plugging the well, pursuant to K.A.R. 82-3-113(b). If a workover pit will be used during the plugging of the well it must be permitted. A CDP-1 form must be filed and approved prior to the use of the pit in accordance with K.A.R. 82-3-600.

The Conservation Division's review of form CP-1, either in the central or district office, does not include an inquiry into well ownership or the filing operator's legal right to plug the well. This notice in no way constitutes authorization to plug the above well by persons not having legal rights of ownership or interest in the well.

This notice is void after October 27, 2008. The CP-1 filing does not bring the above well into compliance with K.A.R. 82-3-111 with regard to the Commission's temporary abandonment requirements.

Sincerely,

Steve Bond

Production Department Supervisor

District: #2
3450 N. Rock Road, Suite 601
Wichita, KS 67226
(316) 630-4000