

15-015-22 601-00-00

Correction 9-21-84

CARD MUST BE TYPED

State of Kansas
NOTICE OF INTENTION TO DRILL
(see rules on reverse side)

CARD MUST BE SIGNED

Starting Date: 9 18 84
month day year

API Number 15-015-22,601

OPERATOR: License # 5476
Name DNB Drilling, Inc.
Address 535 N. Oliver
City/State/Zip Wichita, Ks. 67208
Contact Person Jimmy Donelson
Phone (316) 687-5471

NE NW SW Sec 3 Twp 28 S Rge 3
(location) * 2210 4290
Ft North from Southeast Corner of Section
Ft West from Southeast Corner of Section
(Note: Locate well on Section Plat on reverse side)

CONTRACTOR: License # 5420
Name White and Ellis Drilling, Inc.
City/State El Dorado, Kansas

Nearest lease or unit boundary line 990 feet.
County Butler
Lease Name Trabue Well# 1

Well Drilled For: Well Class: Type Equipment:
 Oil Swd Infield Mud Rotary
 Gas Inj Pool Ext. Air Rotary
 OWWO Expl Wildcat Cable

Domestic well within 330 feet: yes no
Municipal well within one mile: yes no

If OWWO: old well info as follows:
Operator
Well Name
Comp Date Old Total Depth
Projected Total Depth 3100 feet
Projected Formation at TD Simpson
Expected Producing Formations Simpson

Depth to Bottom of fresh water 100 feet
Lowest usable water formation Winfield
Depth to Bottom of usable water 200 feet
Surface pipe by Alternate: 1 2
Surface pipe to be set 200 feet
Conductor pipe if any required 1275 feet
Ground surface elevation feet MSI
This Authorization Expires 3-12-85
Approved By 9-12-84


I certify that we will comply with K.S.A. 55-101, et seq., plus eventually plugging hole to K.C.C. specifications. kwqs 2310 FSL

Date 9-12-84 Signature of Operator or Agent *Jimmy L. Donelson* Title Office Manager

Must be filed with the K.C.C. five (5) days prior to commencing well
 This card void if drilling not started within six (6) months of date received by K.C.C.

Important procedures to follow :

**A Regular Section of Land
 1 Mile = 5,280 Ft.**

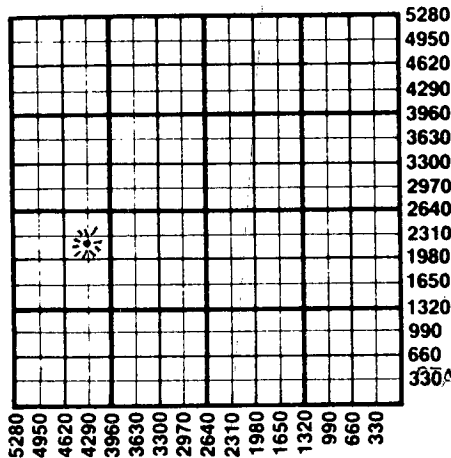

1. Notify District office before setting surface casing.
2. Set surface casing by circulating cement to the top.
3. File completion forms ACO-1 with K.C.C. within 90 days of well completion, following instructions on ACO-1, side 1, and including copies of wireline logs.
4. Notify District office 48 hours prior to old well workover or re-entry.
5. Prior to plugging, prepare a plugging plan, then obtain agreement from the appropriate district office for an approved plugging plan.
6. Submit plugging report (CP-4) to K.C.C. after plugging is completed.
7. Obtain an approved injection docket number before disposing of salt water.
8. Notify K.C.C. within 10 days when injection commences or terminates.

RECEIVED
 If an alternate 2 completion, cement in the production pipe from below
 STATE CORPORATION any usable water to surface within 120 days of spud date.

9/21/84
 SFP 21 1984

CONSERVATION DIVISION
 Wichita, Kansas

**State Corporation Commission of Kansas
 Conservation Division
 200 Colorado Derby Building
 Wichita, Kansas 67202
 (316) 263-3238**