

CARD MUST BE TYPED

State of Kansas
NOTICE OF INTENTION TO DRILL
(see rules on reverse side)

CARD MUST BE SIGNED

Starting Date: 11 19 84
month day year

API Number 15- 0 15-22,645-00-00

OPERATOR: License # 5587
Name Watson Petroleum, Inc.
Address 403 N. Hillcrest
City/State/Zip Wichita, Kansas 67208
Contact Person L.A. Watson
Phone (316) 682-7131

SW. NW. SW. ... Sec .6 Twp .28S, Rge 3E. East
(location) West

..... 1650 Ft North from Southeast Corner of Section
..... 4950 Ft West from Southeast Corner of Section
(Note: Locate well on Section Plat on reverse side)

CONTRACTOR: License # 5420
Name White & Ellis Drilling Co.
City/State El Dorado, Kansas

Nearest lease or unit boundary line 330 feet.
County Butler

Lease Name Pray B Well# 2

Domestic well within 330 feet : yes no
Municipal well within one mile : yes no

Well Drilled For: **Well Class:** **Type Equipment:**
 Oil Swd Infield Mud Rotary
 Gas Inj Pool Ext. Air Rotary
 OWWO Expl Wildcat Cable

Depth to Bottom of fresh water ~~93~~ 93 feet
Lowest usable water formation Wellington

Depth to Bottom of usable water 200 feet

Surface pipe by Alternate : 1 2

Surface pipe to be set 200 feet

Conductor pipe if any required None feet

Ground surface elevation feet MSL

This Authorization Expires 5-16-85

Approved By 11-16-84 

I certify that we will comply with K.S.A. 55-101, et seq., plus eventually plugging hole to K.C.C. specifications.

Date 11/15/84 Signature of Operator or Agent


 Title President

RECEIVED
STATE CORPORATION COMMISSION

11/16/84
NOV 16 1984

WICHITA
Wichita, Kansas

A Regular Section of Land
1 Mile = 5,280 Ft.

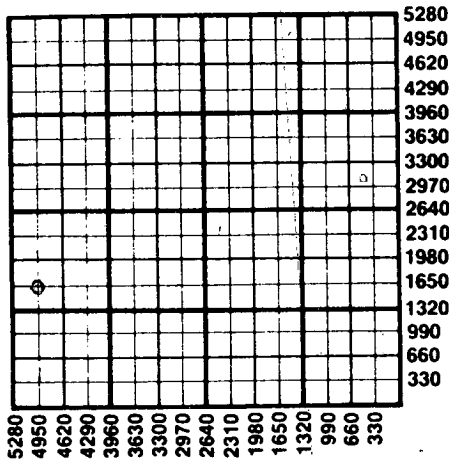

Must be filed with the K.C.C. five (5) days prior to commencing well
This card void if drilling not started within six (6) months of date received by K.C.C.

Important procedures to follow :

1. Notify District office before setting surface casing.
2. Set surface casing by circulating cement to the top.
3. File completion forms ACO-1 with K.C.C. within 90 days of well completion, following instructions on ACO-1, side 1, and including copies of wireline logs.
4. Notify District office 48 hours prior to old well workover or re-entry.
5. Prior to plugging, prepare a plugging plan, then obtain agreement from the appropriate district office for an approved plugging plan.
6. Submit plugging report (CP-4) to K.C.C. after plugging is completed.
7. Obtain an approved injection docket number before disposing of salt water.
8. Notify K.C.C. within 10 days when injection commences or terminates.
9. If an alternate 2 completion, cement in the production pipe from below any usable water to surface within 120 days of spud date.

State Corporation Commission of Kansas
Conservation Division
200 Colorado Derby Building
Wichita, Kansas 67202
(316) 263-3238