

NOTICE OF INTENTION TO DRILL

(see rules on reverse side)

Expected Spud Date... 6/8/88 month day year

OPERATOR: License # 3328

Name Central States Oil & Gas Inc.

Address P.O. Box 129

City/State/Zip Cherryvale, Ks. 67335

Contact Person Cindy Van Dyke

Phone 316-336-3109

CONTRACTOR: License # unknown

Name

City/State

Well Drilled For: Well Class: Type Equipment:

- Oil Storage Infield Mud Rotary
Gas Inj Pool Ext Air Rotary
OWWO Expl Wildcat Cable

If OWWO: old well info as follows:

Operator

Well Name

Comp Date Old Total Depth

I certify that well will comply with K.S.A. 55-101, et seq plus eventually plugging hole to KCC specifications.

Date 6/8/88 Signature of Operator or Agent

API Number 15-099-22,698-00-00
SY2 NE NE Sec. 1 Twp. 34 S, Rg. 17
4200 Ft. from South Line of Section
700 Ft. from East Line of Section

(Note: Locate well on Section Plat on reverse side)

Nearest lease or unit boundary line 700 feet

County Labette

Lease Name Henry Well # SA

Ground surface elevation n/a feet MSL

Domestic well within 330 feet: yes no

Municipal well within one mile: yes no

Depth to bottom of fresh water 100

Depth to bottom of usable water 100

Surface pipe by Alternate: 1 2 X

Surface pipe planned to be set 20

Conductor pipe required 100

Projected Total Depth 900 feet

Formation Mississippi

For KCC Use:

Conductor Pipe Required feet; Minimum Surface Pipe Required 20 feet per Alt. X 2

This Authorization Expires 12-7-88 Approved By RCH 6-7-88


EFFECTIVE DATE: 6-12-88

Must be filed with the K.C.C. five (5) days prior to commencing well  
This card void if drilling not started within six (6) months of date received by K.C.C.

### Important procedures to follow:

1. Notify District office before setting surface casing.
2. Set surface casing by circulating cement to the top.
3. File completion forms ACO-1 with K.C.C. within 120 days of well spud date, following instructions on ACO-1, side 1, and including copies of wireline logs.
4. Notify District office 48 hours prior to old well workover or re-entry.
5. Prior to filing Intent, prepare a proposed plugging plan in case well is D & A, then obtain approval of plan when calling district office prior to setting surface pipe.
6. Submit plugging report (CP-4) to K.C.C. after plugging is completed.
7. Obtain an approved injection docket number before disposing of salt water.
8. Notify K.C.C. within 10 days when injection commences or terminates.

### A Regular Section of Land 1 Mile = 5,280 Ft.

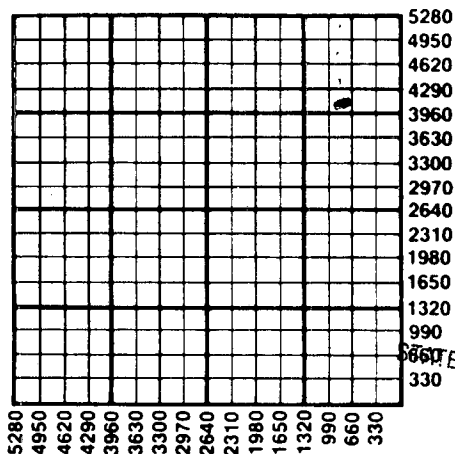

RECEIVED  
STATE CORPORATION COMMISSION

JUN - 7 1988

6-7-88

CONSERVATION DIVISION  
Wichita, Kansas

State Corporation Commission of Kansas  
Conservation Division  
200 Colorado Derby Building  
Wichita, Kansas 67202-1212  
(316) 263-3238