

CARD MUST BE TYPED

State of Kansas
NOTICE OF INTENTION TO DRILL
(see rules on reverse side)

CARD MUST BE SIGNED

Starting Date: 10-15-85
month day year

OPERATOR: License # 9558
Name Simca Oil, Inc.
Address 10720 Horton
City/State/Zip Overland Park, Ks. 66211
Contact Person Rick Andrews
Phone 913-341-8503

CONTRACTOR: License # 5678
Name Harold Brady
City/State Paola, Ks. 66071

Well Drilled For:		Well Class:	Type Equipment:
☐ Oil	☐ Swd	☒ Infield	☐ Mud Rotary
☐ Gas	☒ Inj	☐ Pool Ext.	☒ Air Rotary
☐ OWWO	☐ Expl	☐ Wildcat	☐ Cable

If OWWO: old well info as follows:

Operator
Well Name
Comp Date Old Total Depth
Projected Total Depth 800 feet
Projected Formation at TD Mississippi
Expected Producing Formations

I certify that we will comply with K.S.A. 55-101, et seq., plus eventually plugging hole to K.C.C. specifications.

Date 1-8-85 Signature of Operator or Agent Susan Arnold

API Number 15- 107-22,496-00-00
SE/4 (location) Sec 33 Twp 21 S, Rge 22 ☒ East ☐ West

690 Ft North from Southeast Corner of Section
1045 Ft West from Southeast Corner of Section
(Note: Locate well on Section Plat on reverse side)


Nearest lease or unit boundary line 1-275 feet.
County Linneher
Lease Name D. Ungeheuer Well# 2-1
Domestic well within 330 feet: ☐ yes ☒ no
Municipal well within one mile: ☐ yes ☒ no

Depth to Bottom of fresh water 75 feet
Lowest usable water formation
Depth to Bottom of usable water 150 feet
Surface pipe by Alternate: 1 ☐ 2 ☒
Surface pipe to be set 20 feet
Conductor pipe if any required feet
Ground surface elevation feet MSL
This Authorization Expires 7-8-85
Approved By 1-8-85 KC

Title As Agent
m HC/KDHE 1-8-85

Must be filed with the K.C.C. five (5) days prior to commencing well
This card void if drilling not started within six (6) months of date received by K.C.C.

A Regular Section of Land
1 Mile = 5,280 Ft.

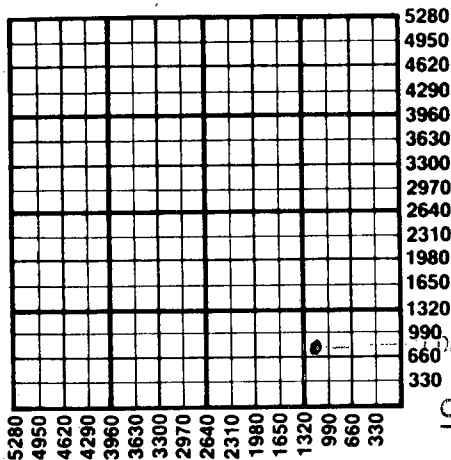

Important procedures to follow :

1. Notify District office before setting surface casing.
 2. Set surface casing by circulating cement to the top.
 3. File completion forms ACO-1 with K.C.C. within 90 days of well completion, following instructions on ACO-1, side 1, and including copies of wireline logs.
 4. Notify District office 48 hours prior to old well workover or re-entry.
 5. Prior to plugging, prepare a plugging plan, then obtain agreement from the appropriate district office for an approved plugging plan.
 6. Submit plugging report (CP-4) to K.C.C. after plugging is completed.
 7. Obtain an approved injection docket number before disposing of salt water.
 8. Notify K.C.C. within 10 days when injection commences or terminates.
9. If an alternate 2 completion, cement in the production pipe from below any usable water to surface within 120 days of spud date.

State Corporation Commission of Kansas
Conservation Division
200 Colorado Derby Building
Wichita, Kansas 67202
(316) 263-3238