

CARD MUST BE TYPED

State of Kansas
NOTICE OF INTENTION TO DRILL
 (see rules on reverse side)

CARD MUST BE SIGNED

Starting Date: 1-15-85
 month day year

OPERATOR: License # 9558
 Name Simca Oil Inc.
 Address 10720 Horton
 City/State/Zip Overland Park, Ks. 66211
 Contact Person Rick Andrews
 Phone 913-341-8503

CONTRACTOR: License # 5678
 Name Harold L. Brady
 City/State Paola, Ks. 66071

Well Drilled For:		Well Class:	Type Equipment:
☐ Oil	☐ Swd	☒ Infield	☐ Mud Rotary
☐ Gas	☒ Inj	☐ Pool Ext.	☒ Air Rotary
☐ OWWO	☐ Expl	☐ Wildcat	☐ Cable

If OWWO: old well info as follows:

Operator
 Well Name
 Comp Date Old Total Depth
 Projected Total Depth 800 feet
 Projected Formation at TD Mississippi
 Expected Producing Formations

API Number 15- 107-22,501-0000
 SE (location) Sec 33 Twp 21 S, Rge 22 ☒ East ☐ West

885 Ft North from Southeast Corner of Section
 10 Ft West from Southeast Corner of Section
 (Note: Locate well on Section Plat on reverse side)

Nearest lease or unit boundary line 10 feet.
 County Linn
 Lease Name D. Ungeheuer Well# 7-1
 Domestic well within 330 feet: ☐ yes ☒ no
 Municipal well within one mile: ☐ yes ☒ no

Depth to Bottom of fresh water 75 feet
 Lowest usable water formation
 Depth to Bottom of usable water 150 feet
 Surface pipe by Alternate: 1 ☐ 2 ☒ 20
 Surface pipe to be set feet
 Conductor pipe if any required feet
 Ground surface elevation feet MSL
 This Authorization Expires 7-8-85
 Approved By 1-8-85

I certify that we will comply with K.S.A. 55-101, et seq., plus eventually plugging hole to K.C.C. specifications.

Date 1-8-85 Signature of Operator or Agent Susan Arnold Title saw agent


MHC/KOHE 1-8-85
 Form C-1 4/84

Must be filed with the K.C.C. five (5) days prior to commencing well
This card void if drilling not started within six (6) months of date received by K.C.C.

Important procedures to follow :

A Regular Section of Land

1 Mile = 5,280 Ft.

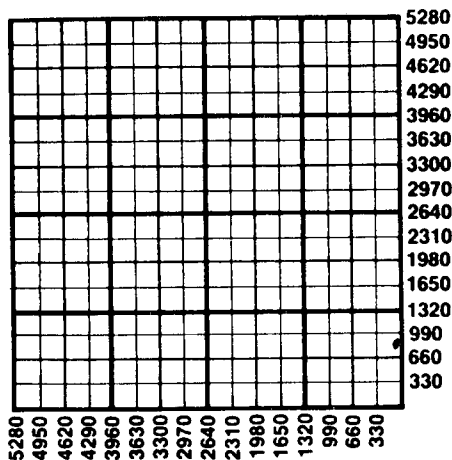

1. Notify District office before setting surface casing.
2. Set surface casing by circulating cement to the top.
3. File completion forms ACO-1 with K.C.C. within 90 days of well completion, following instructions on ACO-1, side 1, and including copies of wireline logs.
4. Notify District office 48 hours prior to old well workover or re-entry.
5. Prior to plugging, prepare a plugging plan, then obtain agreement from the appropriate district office for an approved plugging plan.
6. Submit plugging report (CP-4) to K.C.C. after plugging is completed.
7. Obtain an approved injection docket number before disposing of salt water.
8. Notify K.C.C. within 10 days when injection commences or terminates.
9. If an alternate 2 completion, cement in the production pipe from below any usable water to surface within 120 days of spud date.

State Corporation Commission of Kansas
Conservation Division
200 Colorado Derby Building
Wichita, Kansas 67202
(316) 263-3238

RECEIVED
STATE CORPORATION COMMISSION

58-8-1

8 1985

JAN