

NOTICE OF INTENTION TO DRILL

(see rules on reverse side)

Expected Spud Date... 10 month 21 day 87 year

API Number 15-037-21,413-06-00 Inj
C N 1/2 SW
~~S. W. 4~~ Sec. 33 Twp. 28. S, Rg. 22...
1980 Ft. from South Line of Section
3960 Ft. from East Line of Section

OPERATOR: License # 6766
Name N & W Enterprises, Inc.
Address 1111 S. Margrave
City/State/Zip Fort Scott, Kansas 66701
Contact Person Tom Norris
Phone 316-223-6559

(Note: Locate well on Section Plat on reverse side)
Nearest lease or unit boundary line 600 feet
County Crawford
Lease Name Walsh Well # Inj 3
Ground surface elevation feet MSL
Domestic well within 330 feet: yes no
Municipal well within one mile: yes no
Depth to bottom of fresh water 20'
Depth to bottom of usable water 20'
Surface pipe by Alternate: 1 2
Surface pipe planned to be set 6 5/8"
Conductor pipe required 20'
Projected Total Depth 450 feet
Formation Bartlesville

CONTRACTOR: License # 5868
Name Lewis Drilling
City/State Bronson, Kansas

Well Drilled For: Well Class: Type Equipment:
— Oil — Storage Infield Mud Rotary
— Gas Inj — Pool Ext. — Air Rotary
— OWWO — Expl — Wildcat — Cable

If OWWO: old well info as follows:

Operator
Well Name
Comp Date Old Total Depth

I certify that well will comply with K.S.A. 55-101, et seq., plus eventually plugging hole to KCC specifications.

Date 10/17/87 Signature of Operator or Agent Thomas J. Howard Title Pres.

For KCC Use:

Conductor Pipe Required feet; Minimum Surface Pipe Required 20 feet per Alt. 2

This Authorization Expires 4-20-88 Approved By 10-20-87

EFFECTIVE DATE: 10-25-87


Must be filed with the K.C.C. five (5) days prior to commencing well
This card void if drilling not started within six (6) months of date received by K.C.C.

Important procedures to follow:

1. Notify District office before setting surface casing.
 2. Set surface casing by circulating cement to the top.
 3. File completion forms ACO-1 with K.C.C. within 120 days of well spud date, following instructions on ACO-1, side 1, and including copies of wireline logs.
 4. Notify District office 48 hours prior to old well workover or re-entry.
 5. Prior to filing Intent, prepare a proposed plugging plan in case well is D.&A, then obtain approval of plan when calling district office prior to setting surface pipe.
 6. Submit plugging report (CP-4) to K.C.C. after plugging is completed.
 7. Obtain an approved injection docket number before disposing of salt water.
- Notify K.C.C. within 10 days when injection commences or terminates.

If an alternate 2 completion, cement in the production pipe from below any usable water to surface within 120 days of spud date.

A Regular Section of Land
1 Mile = 5,280 Ft.

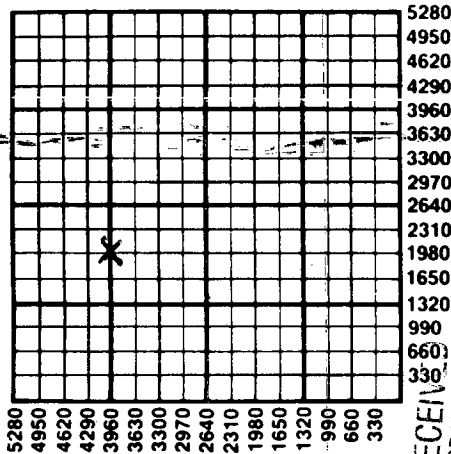

RECEIVED
STATE CORPORATION COMMISSION

OCT 20 1987

CONSERVATION DIVISION
Wichita-Kansas

State Corporation Commission of Kansas
Conservation Division
200 Colorado Derby Building
Wichita, Kansas 67202-1212
(316) 263-3238

10-20-87