

Exp. 11-23-84

State of Kansas Correction
NOTICE OF INTENTION TO DRILL 8-24-84 **CARD MUST BE SIGNED**
(see rules on reverse side)

CARD MUST BE TYPED

Starting Date: 5/23/84
month day year

API Number 15- 037-21,154 - 00-00

OPERATOR: License # 6086
Name The Production Team
Address P. O. Box 785
City/State/Zip Independence, KS 67301
Contact Person Pam Wiseman
Phone 316-331-8541

SW Sec. 2, Twp 28, S, Rge 23
(location) East West

* 330 Ft North from Southeast Corner of Section
* 4705 Ft West from Southeast Corner of Section
(Note: Locate well on Section Plat on reverse side)

CONTRACTOR: License # 5493
Name Pat Chase
City/State Chanute, KS 66720

Nearest lease or unit boundary line 165 feet.
County Crawford
Lease Name Mitchell Well# 3

Well Drilled For: Well Class: Type Equipment:
 Oil Swd Infield Mud Rotary
 Gas Inj Pool Ext. Air Rotary
 OWWO Expl Wildeat Cable

Domestic well within 330 feet: yes no
Municipal well within one mile: yes no

If OWWO: old well info as follows:
Operator
Well Name
Comp Date Old Total Depth
Projected Total Depth feet
Projected Formation at TD
Expected Producing Formations

Depth to Bottom of fresh water 50 feet
Lowest usable water formation
Depth to Bottom of usable water
Surface pipe by Alternate: 1 2
Surface pipe to be set 20 feet
Conductor pipe if any required feet
Ground surface elevation 1032 feet MSL
This Authorization Expires 11-23-84
Approved By 5-23-84

I certify that we will comply with K.S.A. 55-101, et seq., plus eventually plugging hole to K.C.C. specifications. *was: 2,334 FUL of SW 1/4
2,310 FUL*
Date 8/20/84 Signature of Operator or Agent Pam Wiseman Title Agent


Must be filed with the K.C.C. five (5) days prior to commencing well
 This card void if drilling not started within six (6) months of date received by K.C.C.

8-24-84

RECEIVED
 STATE CORPORATION COMMISSION

Important procedures to follow:
 AUG 24 1984

A Regular Section of Land
 1 Mile = 5,280 Ft.

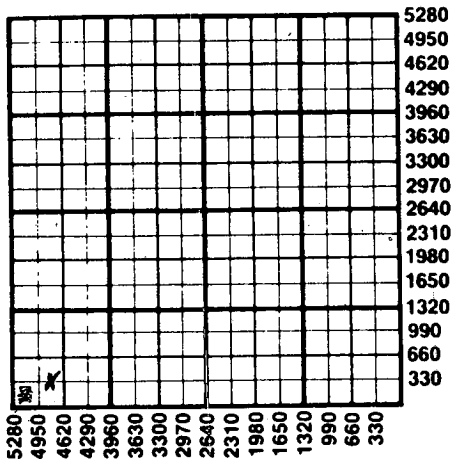

1. Notify District office before setting surface casing.
2. Set surface casing by circulating cement to the top of the well.
3. File completion forms ACO-1 with K.C.C. within 90 days of well completion, following instructions on ACO-1, side 1, and including copies of wireline logs.
4. Notify District office 48 hours prior to old well workover or re-entry.
5. Prior to plugging, prepare a plugging plan, then obtain agreement from the appropriate district office for an approved plugging plan.
6. Submit plugging report (CP-4) to K.C.C. after plugging is completed.
7. Obtain an approved injection docket number before disposing of salt water.
8. Notify K.C.C. within 10 days when injection commences or terminates.
9. If an alternate 2 completion, cement in the production pipe from below any usable water to surface within 120 days of spud date.

CONSERVATION DIVISION
 WICHITA, KANSAS

State Corporation Commission of Kansas
 Conservation Division
 200 Colorado Derby Building
 Wichita, Kansas 67202
 (316) 263-3238