

CARD MUST BE TYPED

State of Kansas
NOTICE OF INTENTION TO DRILL

(see rules on reverse side)

CORRECTION
CARD MUST BE SIGNED

5-17-85

Starting Date: 6/13/84
month day year

API Number 15- 037-21,167 - CORRECTION

OPERATOR: License # 6086

* NW NW SE Sec 3 Twp 28 S, Rge 23
(location) East West

Name The Production Team, Inc.

Address Box 785

City/State/Zip Independence, KS 67301

Contact Person Pam

Phone 316-331-2951

2434 Ft North from Southeast Corner of Section

2410 Ft West from Southeast Corner of Section

(Note: Locate well on Section Plat on reverse side)

CONTRACTOR: License # 5493

Name Pat Chase

City/State Chanute, KS 66720

Nearest lease or unit boundary line 206 feet.

County Crawford

Lease Name Mein Well# 26

Domestic well within 330 feet: yes no

Municipal well within one mile: yes no

Well Drilled For: Well Class: Type Equipment:

- Oil Swd Infield Mud Rotary
- Gas Inj Pool Ext. Air Rotary
- OWWO Expl Wildcat Cable

Depth to Bottom of fresh water 20 feet

Lowest usable water formation 100 feet

Depth to Bottom of usable water

Surface pipe by Alternate: 1 2

Surface pipe to be set 20 feet

Conductor pipe if any required

Ground surface elevation

This Authorization Expires 12-11-84

Approved By 6-11-84

I certify that we will comply with K.S.A. 55-101, et seq., plus eventually plugging hole to K.C.C. specifications.

was 23-28-23E

Date 5/16/85 Signature of Operator or Agent

Susan Arnold

Title As Agent

Must be filed with the K.C.C. five (5) days prior to commencing well
This card void if drilling not started within six (6) months of date received by K.C.C.

RECEIVED
STATE CORPORATION COMMISSION


5-17-85

MAY 17 1985

Important procedures to follow :

A Regular Section of Land
1 Mile = 5,280 Ft.

CONSERVATION DIVISION
Wichita, Kansas

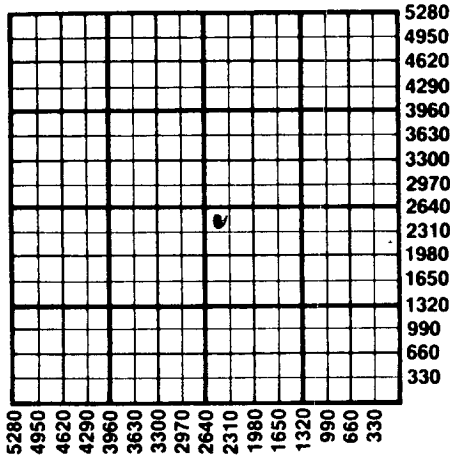

1. Notify District office before setting surface casing.
2. Set surface casing by circulating cement to the top.
3. File completion forms ACO-1 with K.C.C. within 90 days of well completion, following instructions on ACO-1, side 1, and including copies of wireline logs.
4. Notify District office 48 hours prior to old well workover or re-entry.
5. Prior to plugging, prepare a plugging plan, then obtain agreement from the appropriate district office for an approved plugging plan.
6. Submit plugging report (CP-4) to K.C.C. after plugging is completed.
7. Obtain an approved injection docket number before disposing of salt water.
8. Notify K.C.C. within 10 days when injection commences or terminates.
9. If an alternate 2 completion, cement in the production pipe from below any usable water to surface within 120 days of spud date.

State Corporation Commission of Kansas
Conservation Division
200 Colorado Derby Building
Wichita, Kansas 67202
(316) 263-3238