

NOTICE OF INTENTION TO DRILL

(see rules on reverse side)

Expected Spud Date..... 1 9 1988
month day year

API Number 15— 107-22,949-00-00 ¹⁵

OPERATOR: License # 6211
Name Wm H. McCluskey
Address 127 W 10th Suite #430
City/State/Zip Kansas City, Mo. 64105
Contact Person Thomas Moylan
Phone (913) 757-4426

SE SE NW Sec. 15 Twp. 20 S, Rg. 24 East
2970 Ft. from South Line of Section
3255 Ft. from East Line of Section

(Note: Locate well on Section Plat on reverse side)

CONTRACTOR: License # 5872
Name Thomas Moylan
City/State La Cygne, Kansas 66040

Nearest lease or unit boundary line 330 feet
County LINN
Lease Name PEACOCK SOUTH Well # TG-8813

Well Drilled For: Well Class: Type Equipment:
 Oil Storage Infield Mud Rotary
 Gas Inj Pool Ext. Air Rotary
 OWWO Expl Wildcat Cable

Ground surface elevation feet MSL
Domestic well within 330 feet: yes no
Municipal well within one mile: yes no
Depth to bottom of fresh water 20
Depth to bottom of usable water 150
Surface pipe by Alternate: 1 2
Surface pipe planned to be set 55
Conductor pipe required None
Projected Total Depth 400 feet
Formation Squirrel

If OWWO: old well info as follows:
Operator
Well Name
Comp Date Old Total Depth.....


I certify that well will comply with K.S.A. 55-101, et seq., plus eventually plugging hole to KCC specifications.
Date 1-4-88 Signature of Operator or Agent Frank Bruegel Title Agent

For KCC Use:
Conductor Pipe Required feet; Minimum Surface Pipe Required 20 feet per Alt. 2
This Authorization Expires 7-4-88 Approved By PCH 1-4-88

EFFECTIVE DATE: 1-9-88

Must be filed with the K.C.C. five (5) days prior to commencing well
This card void if drilling not started within six (6) months of date received by K.C.C.

A Regular Section of Land
1 Mile = 5,280 Ft.

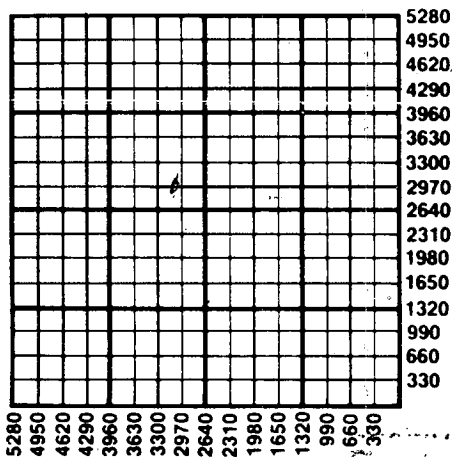

- Important procedures to follow:**
1. Notify District office before setting surface casing.
 2. Set surface casing by circulating cement to the top.
 3. File completion forms ACO-1 with K.C.C. within 120 days of well spud date, following instructions on ACO-1, side 1, and including copies of wireline logs.
 4. Notify District office 48 hours prior to old well workover or re-entry.
 5. Prior to filing Intent, prepare a proposed plugging plan in case well is D & A, then obtain approval of plan when calling district office prior to setting surface pipe.
 6. Submit plugging report (CP-4) to K.C.C. after plugging is completed.
 7. Obtain an approved injection docket number before disposing of salt water.
 8. Notify K.C.C. within 10 days when injection commences or terminates.
 9. If an alternate 2 completion, cement in the production pipe from below any usable water to surface within 120 days of spud date.

STATE OF KANSAS
1-4-88

JAN 4 1988

CONSERVATION DIVISION
Wichita, Kansas

State Corporation Commission of Kansas
Conservation Division
200 Colorado Derby Building
Wichita, Kansas 67202-1212
(316) 263-3238