

CARD MUST BE TYPED

State of Kansas  
**NOTICE OF INTENTION TO DRILL**  
(see rules on reverse side)

CARD MUST BE SIGNED

Starting Date: 4/18/85  
month day year 11:40

OPERATOR: License # 6004  
Name Caldwell Enterprises  
Address Box 42  
City/State/Zip Garnett, KS 66032  
Contact Person Glen Caldwell  
Phone 913-448-3578

CONTRACTOR: License # 5820  
Name Milton J. Kent  
City/State Garnett, KS 66032

Well Drilled For: Well Class: Type Equipment:  
 Oil  Swd  Infield  Mud Rotary  
 Gas  Inj  Pool Ext.  Air Rotary  
 OWWO  Expl  Wildcat  Cable

If OWWO: old well info as follows:  
Operator  
Well Name  
Comp Date Old Total Depth  
Projected Total Depth 850 feet  
Projected Formation at TD  
Expected Producing Formations

API Number 15- 107-22,534-00-00  
S/2 SE SW 25 21 S, Rge 21  East  
(location) Sec Twp S, Rge  West  
220  
3300 Ft North from Southeast Corner of Section  
Ft West from Southeast Corner of Section  
(Note: Locate well on Section Plat on reverse side)

Nearest lease or unit boundary line 220 feet.  
County Linn  
Lease Name Mitchell Well# 1  
Domestic well within 330 feet:  yes  no  
Municipal well within one mile:  yes  no

Depth to Bottom of fresh water 1790 w/hc feet  
Lowest usable water formation Iola Limestone  
Depth to Bottom of usable water 150 feet  
Surface pipe by Alternate: 1  2   
Surface pipe to be set 20 feet  
Conductor pipe if any required feet  
Ground surface elevation feet MSL  
This Authorization Expires 10-15-85  
Approved By 4-15-85 K

I certify that we will comply with K.S.A. 55-101, et seq., plus eventually plugging hole to K.C.C. specifications.

Date 4-15-85 Signature of Operator or Agent Susan Arnold Title As Agent

**Must be filed with the K.C.C. five (5) days prior to commencing well**  
**This card void if drilling not started within six (6) months of date received by K.C.C.**


Wichita, Kansas  
 CONSERVATION DIVISION

APR 15 1985

4-15-85

**Important procedures to follow:**

**A Regular Section of Land**  
 STATE CORPORATION COMMISSION  
 1 Mile = 640 Acres  
 RECEIVED

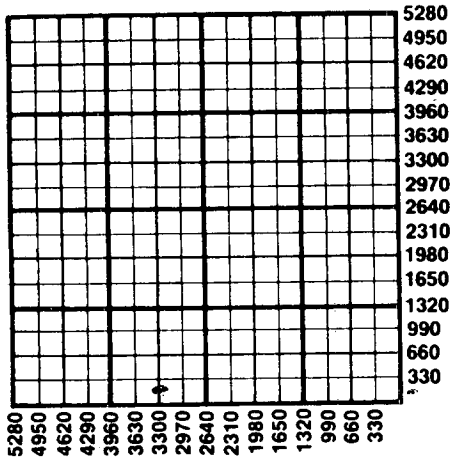

1. Notify District office before setting surface casing.
2. Set surface casing by circulating cement to the top.
3. File completion forms ACO-1 with K.C.C. within 90 days of well completion, following instructions on ACO-1, side 1, and including copies of wireline logs.
4. Notify District office 48 hours prior to old well workover or re-entry.
5. Prior to plugging, prepare a plugging plan, then obtain agreement from the appropriate district office for an approved plugging plan.
6. Submit plugging report (CP-4) to K.C.C. after plugging is completed.
7. Obtain an approved injection docket number before disposing of salt water.
8. Notify K.C.C. within 10 days when injection commences or terminates.
9. If an alternate 2 completion, cement in the production pipe from below any usable water to surface within 120 days of spud date.

**State Corporation Commission of Kansas**  
**Conservation Division**  
**200 Colorado Derby Building**  
**Wichita, Kansas 67202**  
**(316) 263-3238**