

CARD MUST BE TYPED

State of Kansas
NOTICE OF INTENTION TO DRILL
(see rules on reverse side)

CARD MUST BE SIGNED

Starting Date: 5 6 85
month day year 4:00

OPERATOR: License # 5820
Name Milton J. Kent
Address 332 West 8th
City/State/Zip Garnett KS 66032
Contact Person Jerry Kent
Phone (913) 448-3762

CONTRACTOR: License #
Name Company Tools
City/State

Well Drilled For: Well Class: Type Equipment:
 Oil Swd Infield Mud Rotary
 Gas Inj Pool Ext. Air Rotary
 OWWO Expl Wildcat Cable

If OWWO: old well info as follows:
Operator
Well Name
Comp Date Old Total Depth
Projected Total Depth 8.50 feet
Projected Formation at TD Burgess
Expected Producing Formations

API Number 15- 107-22,568 00-00
~~AP#~~ ^{MS/2} S.W. SE Sec . 25. Twp . 21 S, Rge . 21 East West
(location)

..... 220 . Ft North from Southeast Corner of Section
..... 1980 . Ft West from Southeast Corner of Section
(Note: Locate well on Section Plat on reverse side)

Nearest lease or unit boundary line 220 feet.
County Linn
Lease Name Wenker Well# 2
Domestic well within 330 feet : yes no
Municipal well within one mile : yes no

Depth to Bottom of fresh water none 89 feet
Lowest usable water formation
Depth to Bottom of usable water 125 feet
Surface pipe by Alternate : 1 2
Surface pipe to be set 20 feet
Conductor pipe if any required feet
Ground surface elevation feet MSL
This Authorization Expires 11-3-85
Approved By 5-3-85 [Signature]

I certify that we will comply with K.S.A. 55-101, et seq., plus eventually plugging hole to K.C.C. specifications.

Date 5/3/85 Signature of Operator or Agent [Signature] Title AS AGENT

Must be filed with the K.C.C. five (5) days prior to commencing well
 This card void if drilling not started within six (6) months of date received by K.C.C.

RECEIVED

STATE CORPORATION COMMISSION


MAY 3 1985

53-85

A Regular Section of Land
 1 Mile = 5,280 Ft.
 Conservation Division
 Wichita, Kansas

Important procedures to follow :

1. Notify District office before setting surface casing.
2. Set surface casing by circulating cement to the top.
3. File completion forms ACO-1 with K.C.C. within 90 days of well completion, following instructions on ACO-1, side 1, and including copies of wireline logs.
4. Notify District office 48 hours prior to old well workover or re-entry.
5. Prior to plugging, prepare a plugging plan, then obtain agreement from the appropriate district office for an approved plugging plan.
6. Submit plugging report (CP-4) to K.C.C. after plugging is completed.
7. Obtain an approved injection docket number before disposing of salt water.
8. Notify K.C.C. within 10 days when injection commences or terminates.
9. If an alternate 2 completion, cement in the production pipe from below any usable water to surface within 120 days of spud date.

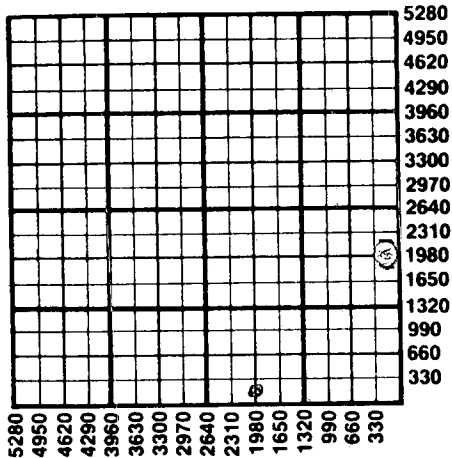

State Corporation Commission of Kansas
 Conservation Division
 200 Colorado Derby Building
 Wichita, Kansas 67202
 (316) 263-3238