

CARD MUST BE TYPED

State of Kansas

CARD MUST BE SIGNED

NOTICE OF INTENTION TO DRILL

(see rules on reverse side)

Starting Date Feb 13, 1986
month day year 10:10

API Number 15— 107-22,789-00-00

OPERATOR: License # 6451
 Name Big E Drilling
 Address Route 1
 City/State/Zip Centerville, Kansas 66014
 Contact Person Mike Eastwood
 Phone 913.898-4082

CONTRACTOR: License #
 Name Company Tools
 City/State

Well Drilled For: Well Class: Type Equipment:
☒ Oil ☐ SWD ☒ Infield ☐ Mud Rotary
☐ Gas ☐ Inj ☐ Pool Ext. ☒ Air Rotary
☐ OWWO ☐ Expl ☐ Wildcat ☐ Cable

If OWWO: old well info as follows:

Operator
 Well Name
 Comp Date Old Total Depth

I certify that well will comply with K.S.A. 55-101, et seq., plus eventually plugging hole to KCC specifications.

Date 2/13/86 Signature of Operator or Agent Shelli Cholar Title as agent

For KCC Use:

Conductor Pipe Required feet: Minimum Surface Pipe Required 20 feet per Alt. 102

This Authorization Expires 8-13-86 Approved By 2-13-86

app. SE SE SW Sec. 4 Twp 21 S, Rg. 22
 300 Ft. from South Line of Section
 3240 Ft. from East Line of Section

(Note: Locate well on Section Plat on reverse side)

Nearest lease or unit boundary line 300 feet
 County Linn
 Lease Name Eastwood Well # B-48
 Ground surface elevation feet MSL
 Domestic well within 330 feet: yes ☒ no
 Municipal well within one mile: yes ☒ no
 Depth to bottom of fresh water 50
 Depth to bottom of usable water 150
 Surface pipe by Alternate: 1 2 ☒
 Surface pipe planned to be set 20
 Conductor pipe required
 Projected Total Depth 700 feet
 Formation Blackshell

DA


K. H. Harte

Must be filed with the K.C.C. five (5) days prior to commencing well
This card void if drilling not started within six (6) months of date received by K.C.C.

Important procedures to follow:

1. Notify District office before setting surface casing.
2. Set surface casing by circulating cement to the top.
3. File completion forms ACO-1 with K.C.C. within 90 days of well completion, following instructions on ACO-1, side 1, and including copies of wireline logs.
4. Notify District office 48 hours prior to old well workover or re-entry.
5. Prior to filing Intent, prepare a proposed plugging plan in case well is D & A, then obtain approval of plan when calling district office prior to setting surface pipe.
6. Submit plugging report (CP-4) to K.C.C. after plugging is completed.
7. Obtain an approved injection docket number before disposing of salt water.
8. Notify K.C.C. within 10 days when injection commences or terminates.

A Regular Section of Land
1 Mile = 5,280 Ft.

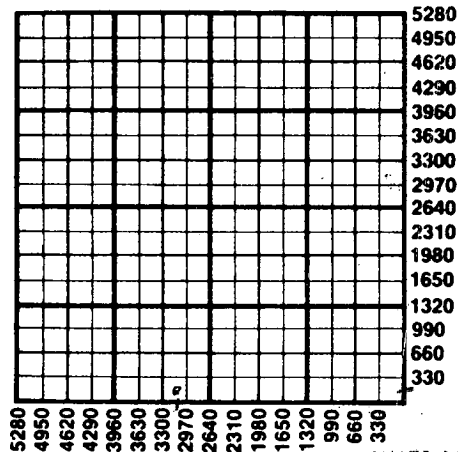

RECEIVED
STATE CORPORATION COMMISSION

FEB 13 1986

CONSERVATION
Wichita, Kansas

9. If an alternate 2 completion, cement in the production pipe from any usable water to surface within 120 days of spud date.

State Corporation Commission of Kansas
Conservation Division
200 Colorado Derby Building
Wichita, Kansas 67202
(316) 263-3238

2-13-86