

CARD MUST BE TYPED

State of Kansas  
**NOTICE OF INTENTION TO DRILL**  
(see rules on reverse side)

CARD MUST BE SIGNED

Starting Date: Approx 12 31 84  
month day year

API Number 15- 107-22,471-00-00

OPERATOR: License # 5618  
Name L&L Enterprises, Inc.  
Address Box 85  
City/State/Zip Derby, Kansas 67037  
Contact Person Bill Ham  
Phone 316-263-8138

Approx. C. SW. SW. Sec. 7 Twp. 21 S, Rge. 22 East  
(location) (W  $\frac{1}{2}$  of Sec. 7 is short)  
760 Ft North from Southeast Corner of Section  
3290 Ft West from Southeast Corner of Section  
(Note: Locate well on Section Plat on reverse side)

CONTRACTOR: License # 5830  
Name Exploration, Inc.  
City/State 610 Petro. Bldg. Wichita, KS

Nearest lease or unit boundary line .550 feet.  
County Linn  
Lease Name Florence Gorrell Well# 7  
Domestic well within 330 feet:  yes  no  
Municipal well within one mile:  yes  no

Well Drilled For: Well Class: Type Equipment:  
 Oil  Swd  Infield  Mud Rotary  
 Gas  Inj  Pool Ext.  Air Rotary  
 OWWO  Expl  Wildcat  Cable

Depth to Bottom of fresh water 60 mhc feet  
Lowest usable water formation Pleasanton Gr.  
Depth to Bottom of usable water 150 feet  
Surface pipe by Alternate:  1  2  
Surface pipe to be set 20 feet  
Conductor pipe if any required ..... feet  
Ground surface elevation +901 feet MSL  
This Authorization Expires 6-28-85  
Approved By R.C.H./K.C.C. 12-25-84

If OWWO: old well info as follows:  
Operator .....  
Well Name .....  
Comp Date ..... Old Total Depth .....  
Projected Total Depth 550 feet  
Projected Formation at TD Squirrel Sd.  
Expected Producing Formations Squirrel Sd.

I certify that we will comply with K.S.A. 55-101, et seq., plus eventually plugging hole to K.C.C. specifications.

Date 12/27/84 Signature of Operator or Agent Bill Ham - agent for L&L Enterprises, Inc.


Title Area-Exploration  
mhc/UDHE 12/28/84  
Form C-1 4/84

Must be filed with the K.C.C. five (5) days prior to commencing well  
 This card void if drilling not started within six (6) months of date received by K.C.C.

DEC 28 1984

STATE CORPORATION COMMISSION  
 A Regular Section of Land  
 1 Mile = 5,280 Ft.

12-28-84

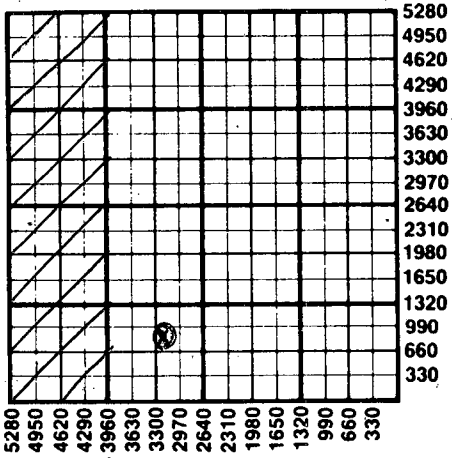

W 1/2 is short

**Important procedures to follow:**

1. Notify District office before setting surface casing.
2. Set surface casing by circulating cement to the top.
3. File completion forms ACO-1 with K.C.C. within 90 days of well completion, following instructions on ACO-1, side 1, and including copies of wireline logs.
4. Notify District office 48 hours prior to old well workover or re-entry.
5. Prior to plugging, prepare a plugging plan; then obtain agreement from the appropriate district office for an approved plugging plan.
6. Submit plugging report (CP-4) to K.C.C. after plugging is completed.
7. Obtain an approved injection docket number before disposing of salt water.
8. Notify K.C.C. within 10 days when injection commences or terminates.
9. If an alternate 2 completion, cement in the production pipe from below any usable water to surface within 120 days of spud date.

State Corporation Commission of Kansas  
 Conservation Division  
 200 Colorado Derby Building  
 Wichita, Kansas 67202  
 (316) 263-3238