

CARD MUST BE TYPED
Using same pits as #1 Well

State of Kansas

CARD MUST BE SIGNED

NOTICE OF INTENTION TO DRILL

(see rules on reverse side)

Expected Spud Date..... 5..... 15..... 1988.....
month day year

API Number 15— 107-22,993-00-00 ✓ DC

OPERATOR: License # 04989
Name Jack E. Cook
Address 1213 West Third
City/State/Zip El Dorado, Ks. 67042
Contact Person David W Cook
Phone (316) 321-5091

NE SW SW Sec 23 Twp 21 S, Rg 24
900 Ft. from South Line of Section
4300 Ft. from East Line of Section

(Note: Locate well on Section Plat on reverse side)

CONTRACTOR: License #
Name
City/State

Nearest lease or unit boundary line 320 feet
County Linn

Lease Name Youvan Well # 3 Twin to #1

Ground surface elevation feet MSL

Domestic well within 330 feet: —yes no

Municipal well within one mile: —yes no

Depth to bottom of fresh water

Depth to bottom of usable water 150

Surface pipe by Alternate: 1 2

Surface pipe planned to be set 20 Ft.

Conductor pipe required No

Projected Total Depth 495 feet

Formation Cherokee

Well Drilled For: Well Class: Type Equipment:
— Oil — Storage — Infield — Mud Rotary
 Gas — Inj — Pool Ext. Air Rotary
— OWWO — Expl Wildcat — Cable

If OWWO: old well info as follows:

Operator
Well Name
Comp Date Old Total Depth

I certify that well will comply with K.S.A. 55-101, et seq., plus eventually plugging hole to KCC specifications.

Date 4/28/88 Signature of Operator or Agent Jack E. Cook Title Owner

For KCC Use:


Conductor Pipe Required feet; Minimum Surface Pipe Required 20 feet per Alt. X (2)

This Authorization Expires 10-29-88 Approved By Feb 4-29-88

EFFECTIVE DATE: 5-4-88

Must be filed with the K.C.C. five (5) days prior to commencing well
This card void if drilling not started within six (6) months of date received by K.C.C.

A Regular Section of Land
1 Mile = 5,280 Ft.

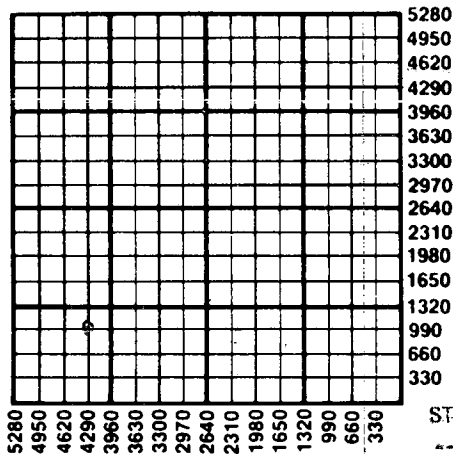

Important procedures to follow:

1. Notify District office before setting surface casing.
2. Set surface casing by circulating cement to the top.
3. File completion forms ACO-1 with K.C.C. within 120 days of well spud date, following instructions on ACO-1, side 1, and including copies of wireline logs.
4. Notify District office 48 hours prior to old well workover or re-entry.
5. Prior to filing Intent, prepare a proposed plugging plan in case well is D & A, then obtain approval of plan when calling district office prior to setting surface pipe.
6. Submit plugging report (CP-4) to K.C.C. after plugging is completed.
7. Obtain an approved injection docket number before disposing of salt water.
8. Notify K.C.C. within 10 days when injection commences or terminates.

RECEIVED

STATE CORPORATION COMMISSION

APR 29 1988

CONSERVATION DIVISION
Wichita, Kansas

4-29-88

9. If an alternate 2 completion, cement in the production pipe from below any usable water to surface within 120 days of spud date.

State Corporation Commission of Kansas
Conservation Division
200 Colorado Derby Building
Wichita, Kansas 67202-1212
(316) 263-3238