

NOTICE OF INTENTION TO DRILL

(see rules on reverse side)

Starting Date July 25 86 month day year

API Number 15- 015-22, 918-00-00

OPERATOR: License # 9913 Name Bullseye Petroleum, Inc. Address 500 N. Sagebrush City/State/Zip Wichita, Ks. 67230 Contact Person William Ash Phone 316-733-5280

NE. NEQ. Sec. 9 Twp. 28. S, Rg. 3 West 2310 Ft. from South Line of Section 2970 Ft. from East Line of Section

(Note: Locate well on Section Plat on reverse side)

CONTRACTOR: License # 5302 Name Red Tiger Drlg. Co. City/State Wichita, Ks. 67202

Nearest lease or unit boundary line 330 feet County Butler Lease Name Kelly Well # 1-9

Well Drilled For: XX Oil SWD Infield XX Mud Rotary Gas Inj XX Pool Ext. Air Rotary OWWO Expl Wildcat Cable

Ground surface elevation 1335+- feet MSL Domestic well within 330 feet: yes no Municipal well within one mile: yes no Depth to bottom of fresh water 85 Depth to bottom of usable water 200 Surface pipe by Alternate 1 2 Surface pipe planned to be set 200+ Conductor pipe required Projected Total Depth 3100 Formation Simpson

If OWWO: old well info as follows: Operator Well Name Comp Date Old Total Depth

I certify that well will comply with K.S.A. 55-101, et seq., plus eventually plugging hole to KCC specifications. Date 7-24-86 Signature of Operator or Agent Title Vice Pres./Prod. Oper

For KCC Use: Conductor Pipe Required feet; Minimum Surface Pipe Required feet per Alt. This Authorization Expires 1-25-87 Approved By 7-25-86


Handwritten signature and initials: RWA/KCC

Must be filed with the K.C.C. five (5) days prior to commencing well  
This card void if drilling not started within six (6) months of date received by K.C.C.

**Important procedures to follow:**

1. Notify District office before setting surface casing.
2. Set surface casing by circulating cement to the top.
3. File completion forms ACO-1 with K.C.C. within 90 days of well completion, following instructions on ACO-1, side 1, and including copies of wireline logs.
4. Notify District office 48 hours prior to old well workover or re-entry.
5. Prior to filing Intent, prepare a proposed plugging plan in case well is D & A, then obtain approval of plan when calling district office prior to setting surface pipe.
6. Submit plugging report (CP-4) to K.C.C. after plugging is completed.
7. Obtain an approved injection docket number before disposing of salt water.
8. Notify K.C.C. within 10 days when injection commences or terminates.
9. If an alternate 2 completion, cement in the production pipe from below any usable water to surface within 120 days of spud date.

**A Regular Section of Land**  
**1 Mile = 5,280 Ft.**

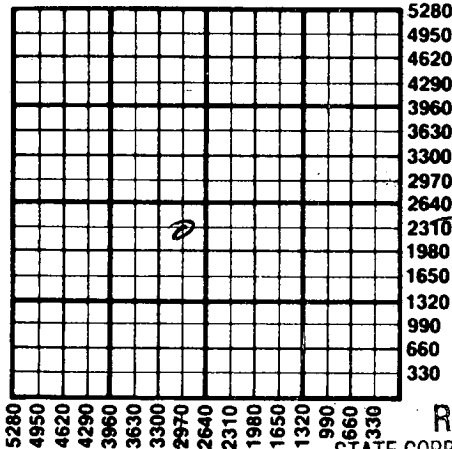

RECEIVED  
STATE CORPORATION COMMISSION

7/25/86  
JUL 25 1986

CONSERVATION DIVISION  
Wichita, Kansas

State Corporation Commission of Kansas  
Conservation Division  
200 Colorado Derby Building  
Wichita, Kansas 67202  
(316) 263-3238