

CARD MUST BE TYPED

State of Kansas
NOTICE OF INTENTION TO DRILL
(see rules on reverse side)

CARD MUST BE SIGNED

Starting Date: January 10, 1985
month day year

API Number 15- 015-22,671-00-00

OPERATOR: License # 6147, 6264, 6190
Name Wiley Ash, Sr., Wiley Ash, Jr., Wm G. Ash
Address Rt. 1, Box 114
City/State/Zip Rose Hill, Kansas 67133
Contact Person Wiley R. Ash, Sr.
Phone 316-733-2013

C. E $\frac{1}{2}$ SW. NE Sec. 9 Twp 28S. S, Rge 3. East
(location) West
4510 Ft North from Southeast Corner of Section
1860 Ft West from Southeast Corner of Section
(Note: Locate well on Section Plat on reverse side)

CONTRACTOR: License # 5824
Name Reynolds Drlg. Co., Inc.
City/State Winfield, Kansas 67156

Nearest lease or unit boundary line 660 feet.
County Butler
Lease Name C-J Hooper Well# 3

Well Drilled For: Well Class: Type Equipment:
 Oil Swd Infield Mud Rotary
 Gas Inj Pool Ext. Air Rotary
 OWWO Expl Wildcat Cable

Domestic well within 330 feet: yes no
Municipal well within one mile: yes no

If OWWO: old well info as follows:
Operator
Well Name
Comp Date Old Total Depth
Projected Total Depth 3150 feet
Projected Formation at TD Simpson
Expected Producing Formations Kansas City/Simpson

Depth to Bottom of fresh water 120 feet
Lowest usable water formation
Depth to Bottom of usable water 200 feet
Surface pipe by Alternate: 1 2
Surface pipe to be set 200 feet
Conductor pipe if any required feet
Ground surface elevation 1316 feet MSL
This Authorization Expires 7-8-85
Approved By 1-8-85 *R*

I certify that we will comply with K.S.A. 55-101, et seq., plus eventually plugging hole to K.C.C. specifications.

Date 1-8-85 Signature of Operator or Agent *Wiley R. Ash, Sr.*

Title Co-Operator

mhc/KOHE 1-8-85 Form C-1 4/84

Must be filed with the K.C.C. five (5) days prior to commencing well
 This card void if drilling not started within six (6) months of date received by K.C.C.


RECEIVED
 STATE CORPORATION COMMISSION

1/8/85

JAN 8 1985

Important procedures to follow:

A Regular Section of Land
1 Mile = 5,280 Ft.

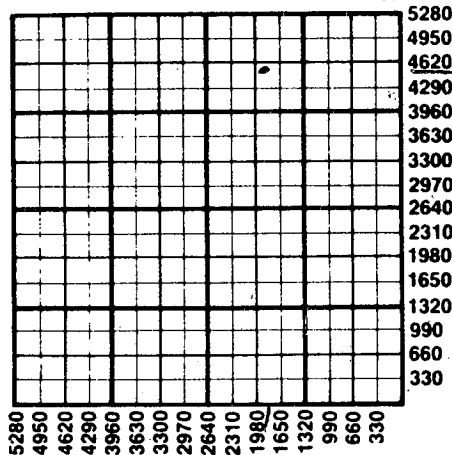

1. Notify District office before setting surface casing CONSERVATION DIVISION
Wichita, Kansas
2. Set surface casing by circulating cement to the top.
3. File completion forms ACO-1 with K.C.C. within 90 days of well completion, following instructions on ACO-1, side 1, and including copies of wireline logs.
4. Notify District office 48 hours prior to old well workover or re-entry.
5. Prior to plugging, prepare a plugging plan, then obtain agreement from the appropriate district office for an approved plugging plan.
6. Submit plugging report (CP-4) to K.C.C. after plugging is completed.
7. Obtain an approved injection docket number before disposing of salt water.
8. Notify K.C.C. within 10 days when injection commences or terminates.
9. If an alternate 2 completion, cement in the production pipe from below any usable water to surface within 120 days of spud date.

State Corporation Commission of Kansas
 Conservation Division
 200 Colorado Derby Building
 Wichita, Kansas 67202
 (316) 263-3238