

CARD MUST BE TYPED

State of Kansas
NOTICE OF INTENTION TO DRILL
(see rules on reverse side)

CORRECTION
CARD MUST BE SIGNED
6-12-85

Starting Date: 6 6 85
month day year

* API Number 15- *015-27,732-00-00*

OPERATOR: License # *6190,6147,6264*
Name *William G. Ash, Wiley Ash, Sr., Wiley Ash, Jr.*
Address *324 W. Central-Box 633*
City/State/Zip *Andover, Kansas 67002*
Contact Person *William G. Ash*
Phone *316-733-2013*

C NW $\frac{1}{4}$ Sec 15 Twp 28S S, Rge 3 East
(location) West
..... 3960 Ft North from Southeast Corner of Section
..... 3960 Ft West from Southeast Corner of Section
(Note: Locate well on Section Plat on reverse side)

CONTRACTOR: License # *5824*
Name *Reynolds Drilling Co., Inc.*
City/State *Winfield, Ks. 67156*

Nearest lease or unit boundary line *1320* feet.
County *Butler*
Lease Name *Young-Hales* Well# *1*
Domestic well within 330 feet : yes no
Municipal well within one mile : yes no

Well Drilled For: Well Class: Type Equipment:
 Oil Swd Infield Mud Rotary
 Gas Inj Pool Ext. Air Rotary
 OWWO Expl Wildcat Cable

Depth to Bottom of fresh water *200* *120* feet
Lowest usable water formation *Winfield*
Depth to Bottom of usable water *200* feet
Surface pipe by Alternate : 1 2
Surface pipe to be set *200* feet
Conductor pipe if any required feet
Ground surface elevation *1315* feet MSL
This Authorization Expires *11-28-85*
Approved By *WGS 27,732* *RCH FOR KDHE* *Wiley Ash*

If OWWO: old well info as follows:
Operator
Well Name
Comp Date Old Total Depth
Projected Total Depth *3150* feet
Projected Formation at TD *Simpson*
Expected Producing Formations *KC./Simpson*


I certify that we will comply with K.S.A. 55-101, et seq., plus eventually plugging hole to K.C.C. specifications
Date *5-28-85* Signature of Operator or Agent *William G. Ash* Title *Co-Operator*
WGS 27,732
RCH FOR KDHE

Must be filed with the K.C.C. five (5) days prior to commencing well
This card void if drilling not started within six (6) months of date received by K.C.C.

RECEIVED
STATE CORPORATION COMMISSION

5/28/85
MAY 29 1985

A Regular Section of Land
1 Mile = 5,280 Ft.
CONSERVATION DIVISION
Wichita, Kansas

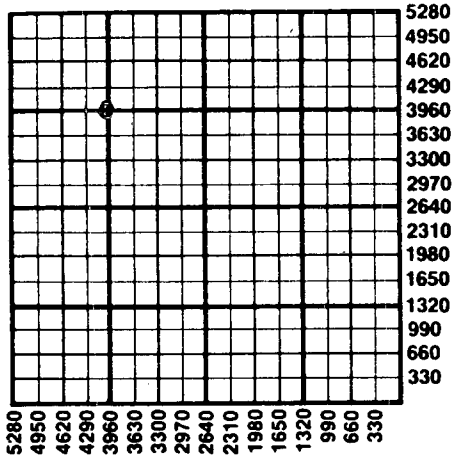

Important procedures to follow :

1. Notify District office before setting surface casing.
2. Set surface casing by circulating cement to the top.
3. File completion forms ACO-1 with K.C.C. within 90 days of well completion, following instructions on ACO-1, side 1, and including copies of wireline logs.
4. Notify District office 48 hours prior to old well workover or re-entry.
5. Prior to plugging, prepare a plugging plan, then obtain agreement from the appropriate district office for an approved plugging plan.
6. Submit plugging report (CP-4) to K.C.C. after plugging is completed.
7. Obtain an approved injection docket number before disposing of salt water.
8. Notify K.C.C. within 10 days when injection commences or terminates.
9. If an alternate 2 completion, cement in the production pipe from below any usable water to surface within 120 days of spud date.

State Corporation Commission of Kansas
Conservation Division
200 Colorado Derby Building
Wichita, Kansas 67202
(316) 263-3238