

NOTICE OF INTENTION TO DRILL

(see rules on reverse side)

Expected Spud Date. 04-20-87 month day year

API Number 15- 015-22,977-00-00

OPERATOR: License # 6101 Name Teichgraeber Oil Operations Address P. O. Box 471 City/State/Zip El Dorado, KS. 67042 Contact Person R. K. Teichgraeber Phone (316) 321-2770

NW NE SW Sec. 25 Twp. 28 S, Rg. 3 2310 Ft. from South Line of Section 3630 Ft. from East Line of Section

CONTRACTOR: License # 5676 Name EDCO Drilling Company, Inc. City/State El Dorado, KS. 67042

(Note: Locate well on Section Plat on reverse side) Nearest lease or unit boundary line 330 feet County Butler Lease Name Goeken Well # 1 Ground surface elevation 1320 feet MSL Domestic well within 330 feet: yes X no

Well Drilled For: Well Class: Type Equipment: X Oil Storage Infield X Mud Rotary Gas Inj Pool Ext Air Rotary OWWO Expl X Wildcat Cable

Municipal well within one mile: yes X no Depth to bottom of fresh water 140 Depth to bottom of usable water 200 Surface pipe by Alternate: 1 X 2 Surface pipe planned to be set 200' Conductor pipe required None Projected Total Depth 3,000 feet Formation Arbuckle

If OWWO: old well info as follows: Operator Well Name Comp Date Old Total Depth

I certify that well will comply with K.S.A. 55-101, et seq., plus eventually plugging hole to KCC specifications. Date Signature of Operator or Agent R. K. Teichgraeber Title

For KCC Use: Conductor Pipe Required feet; Minimum Surface Pipe Required 200 feet per Alt. 1 2 This Authorization Expires 10-15-87 Approved By 4-15-87


Handwritten signatures and initials at the bottom right of the page.

Must be filed with the K.C.C. five (5) days prior to commencing well
 This card void if drilling not started within six (6) months of date received by K.C.C.

Important procedures to follow:

1. Notify District office before setting surface casing.
2. Set surface casing by circulating cement to the top.
3. File completion forms ACO-1 with K.C.C. within 120 days of well spud date, following instructions on ACO-1, side 1, and including copies of wireline logs.
4. Notify District office 48 hours prior to old well workover or re-entry.
5. Prior to filing Intent, prepare a proposed plugging plan in case well is D & A, then obtain approval of plan when calling district office prior to setting surface pipe.
6. Submit plugging report (CP-4) to K.C.C. after plugging is completed.
7. Obtain an approved injection docket number before disposing of salt water.
8. Notify K.C.C. within 10 days when injection commences or terminates.
9. If an alternate 2 completion, cement in the production pipe from below any usable water to surface within 120 days of spud date.

A Regular Section of Land
 1 Mile = 5,280 Ft.

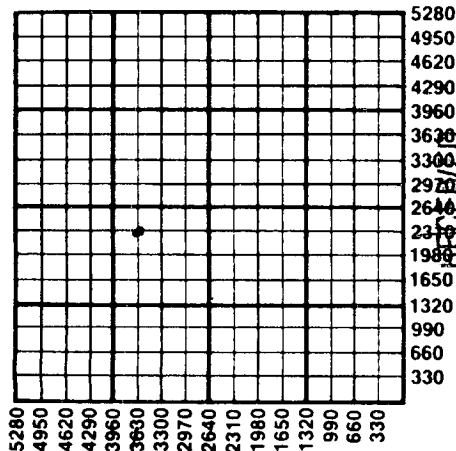

STATE CORPORATION COMMISSION
 REC'D
 4/15/87
 APR 15 1987

MINING DIVISION
 Wichita, Kansas

State Corporation Commission of Kansas
 Conservation Division
 200 Colorado Derby Building
 Wichita, Kansas 67202-1212
 (316) 263-3238