

CARD MUST BE TYPED

State of Kansas

CARD MUST BE SIGNED

NOTICE OF INTENTION TO DRILL

CORRECTION

(see rules on reverse side)

Starting Date 4 month 1 day 87 year

API Number 15— 099-22,542-47787
00-00

OPERATOR: License # 5499

Sec. 11 Twp. 31 S, Rg. 18 West

Name Brecheisen Oil Co.

Address Box 40

City/State/Zip Garnett, Kansas 66032

Contact Person A. W. Brecheisen

Phone 913-448-6952

1320 Ft. from South Line of Section
330 Ft. from East Line of Section

(Note: Locate well on Section Plat on reverse side)

CONTRACTOR: License # 5379

Name Kephart Drilling, Inc.

City/State Thayer, Kansas

Nearest lease or unit boundary line 330 feet

County Labette

Lease Name Bogner Well # 3

Ground surface elevation feet MSL

Domestic well within 330 feet: —yes no

Municipal well within one mile: —yes no

Depth to bottom of fresh water..... 15'

Depth to bottom of usable water 200'

Surface pipe by Alternate: 1 — 2

Surface pipe planned to be set 21'

Conductor pipe required none

Projected Total Depth 375' 950 feet

Formation Dennis sand

If OWWO: old well info as follows:

Operator

Well Name

Comp Date Old Total Depth.....

I certify that well will comply with K.S.A. 55-101, et seq., plus eventually plugging hole to KCC specifications.

Date 3-17-87..... Signature of Operator or Agent A.W. Brecheisen Title Owner

For KCC Use:


Conductor Pipe Required feet; Minimum Surface Pipe Required 20 feet per Alt. # 9

This Authorization Expires 9-19-87 Approved By 3-19-87

*was: T.D. 375' [Signature]

Must be filed with the K.C.C. five (5) days prior to commencing well
This card void if drilling not started within six (6) months of date received by K.C.C.

A Regular Section of Land
1 Mile = 5,280 Ft.

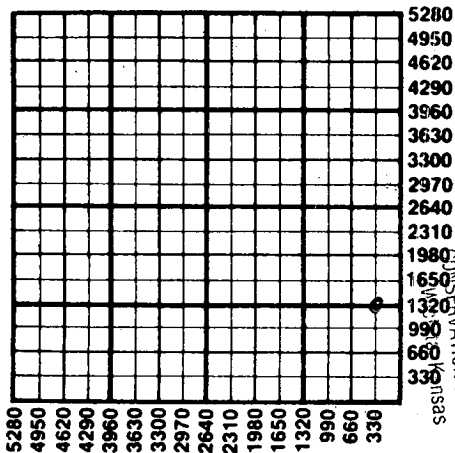

STATE CORPORATION COMMISSION
CONSERVATION DIVISION
MAR 19 1987
Wichita, Kansas

3-19-87

Important procedures to follow:

1. Notify District office before setting surface casing.
2. Set surface casing by circulating cement to the top.
3. File completion forms ACO-1 with K.C.C. within 90 days of well completion, following instructions on ACO-1, side 1, and including copies of wireline logs.
4. Notify District office 48 hours prior to old well workover or re-entry.
5. Prior to filing Intent, prepare a proposed plugging plan in case well is D & A, then obtain approval of plan when calling district office prior to setting surface pipe.
6. Submit plugging report (CP-4) to K.C.C. after plugging is completed.
7. Obtain an approved injection docket number before disposing of salt water:
8. Notify K.C.C. within 10 days when injection commences or terminates.
9. If an alternate 2 completion, cement in the production pipe from below any usable water to surface within 120 days of spud date.

State Corporation Commission of Kansas
Conservation Division
200 Colorado Derby Building
Wichita, Kansas 67202
(316) 263-3238