

NOTICE OF INTENTION TO DRILL

(see rules on reverse side)

Starting Date 4 month 3 day 87 year

API Number 15— 099-22,543-00-00

OPERATOR: License # 5499
Name Brecheisen Oil Co.
Address Box 40
City/State/Zip Garnett, Kansas 66032
Contact Person A. W. Brecheisen
Phone 913-448-6952

SE. SE SE. Sec. 11.. Twp. 31.. S, Rg. 18... X East
330 Ft. from South Line of Section
495 Ft. from East Line of Section

(Note: Locate well on Section Plat on reverse side)

CONTRACTOR: License # 5379
Name Kephart Drilling, Inc.
City/State Thayer, Kansas

Nearest lease or unit boundary line 330 feet
County Labette
Lease Name Bogner Well # 4

Well Drilled For: Well Class: Type Equipment:
Oil SWD XX Infield Mud Rotary
X Gas Inj Pool Ext. X Air Rotary
OWWO Expl Wildcat Cable

Ground surface elevation feet MSL
Domestic well within 330 feet: yes X no
Municipal well within one mile: yes X no
Depth to bottom of fresh water 15'
Depth to bottom of usable water 200'
Surface pipe by Alternate: 1 2X
Surface pipe planned to be set 21'
Conductor pipe required none
Projected Total Depth 375 feet
Formation Dennis sand

If OWWO: old well info as follows:
Operator
Well Name
Comp Date Old Total Depth

I certify that well will comply with K.S.A. 55-101, et seq., plus eventually plugging hole to KCC specifications.

Date 3-17-87 Signature of Operator or Agent A. W. Brecheisen Title Owner

For KCC Use:

Conductor Pipe Required feet; Minimum Surface Pipe Required 20 feet per Alt.
This Authorization Expires 9-19-87 Approved By 3-19-87


Handwritten signature and initials at the bottom right of the page.

Must be filed with the K.C.C. five (5) days prior to commencing well
This card void if drilling not started within six (6) months of date received by K.C.C.

Important procedures to follow:

1. Notify District office before setting surface casing.
2. Set surface casing by circulating cement to the top.
3. File completion forms ACO-1 with K.C.C. within 90 days of well completion, following instructions on ACO-1, side 1, and including copies of wireline logs.
4. Notify District office 48 hours prior to old well workover or re-entry.
5. Prior to filing Intent, prepare a proposed plugging plan in case well is D & A, then obtain approval of plan when calling district office prior to setting surface pipe.
6. Submit plugging report (CP-4) to K.C.C. after plugging is completed.
7. Obtain an approved injection docket number before disposing of salt water.
8. Notify K.C.C. within 10 days when injection commences or terminates.
9. If an alternate 2 completion, cement in the production pipe from below any usable water to surface within 120 days of spud date.

**A Regular Section of Land
1 Mile = 5,280 Ft.**

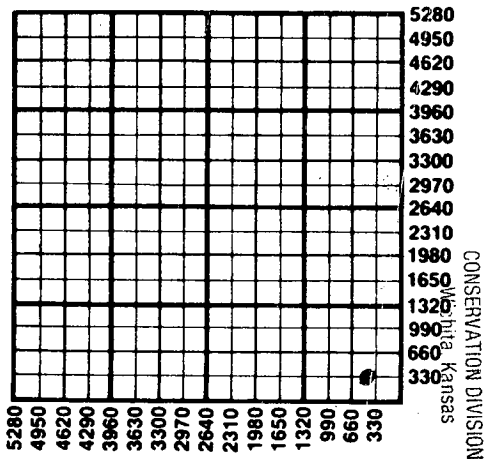

MAR 19 1987

STATE CORPORATION COMMISSION

State Corporation Commission of Kansas
Conservation Division
200 Colorado Derby Building
Wichita, Kansas 67202
(316) 263-3238

3-19-87